

RECEIVED


OCT 04 2010

WATER RESOURCES DEPT
CALIFORNIA OREGON

Claim of Beneficial Use

Permit G-15988 (Application G-16424)

Township 2 South, Range 1 East, Section 12 (W.M.)

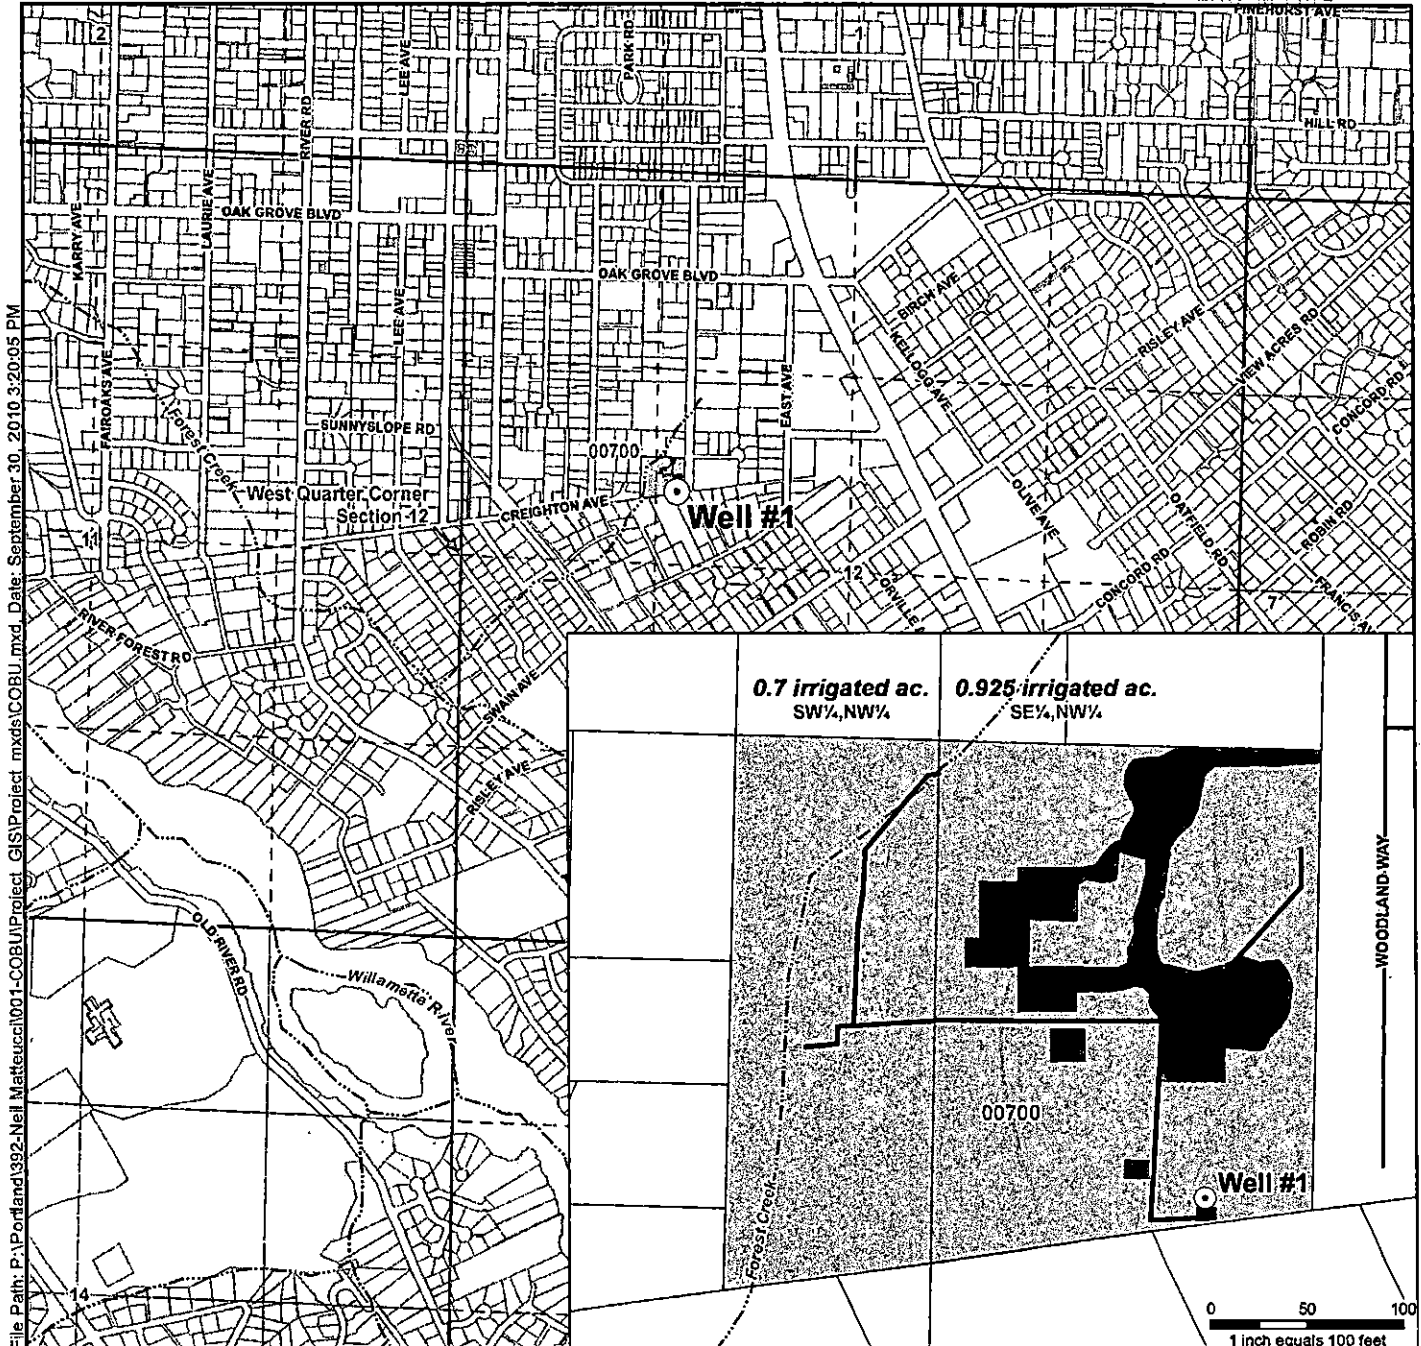

File Path: P:\Portland\392-Neil Matfeucc1001-COBU\Project_GIS\Project_mxd\COBU.mxd Date: September 30, 2010 3:20:05 PM


LEGEND

- Point of Appropriation (POA)
- Place of Use (POU)
- Meter
- Non Irrigated
- Mainlines
- Taxlots
- Watercourses

POA Location Description

Well #1
Located 498 feet North and 1490 feet East from the W1/4 corner of Section 12, Township 2 South, Range 1 East (W.M.)

Certified Water Rights Examiner Stamp

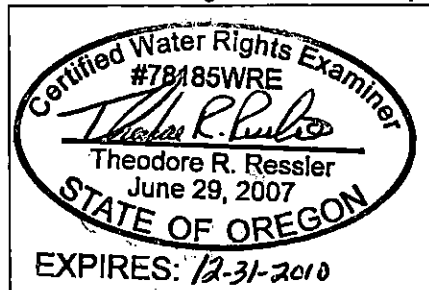

Disclaimer

This map was prepared for the purpose of identifying the location of a water right only and it is not intended to provide legal dimensions or location of property ownership lines.

Map Notes

Date: September 30, 2010
Data Sources: METRO
Prepared By: GSI Water Solutions, Inc.



0 330 660 990 1320
1 inch equals 1320 feet

