


TOWNSHIP 16 SOUTH, RANGE 2 EAST, W.M.
SECTION 29

COBU MAP # 0613

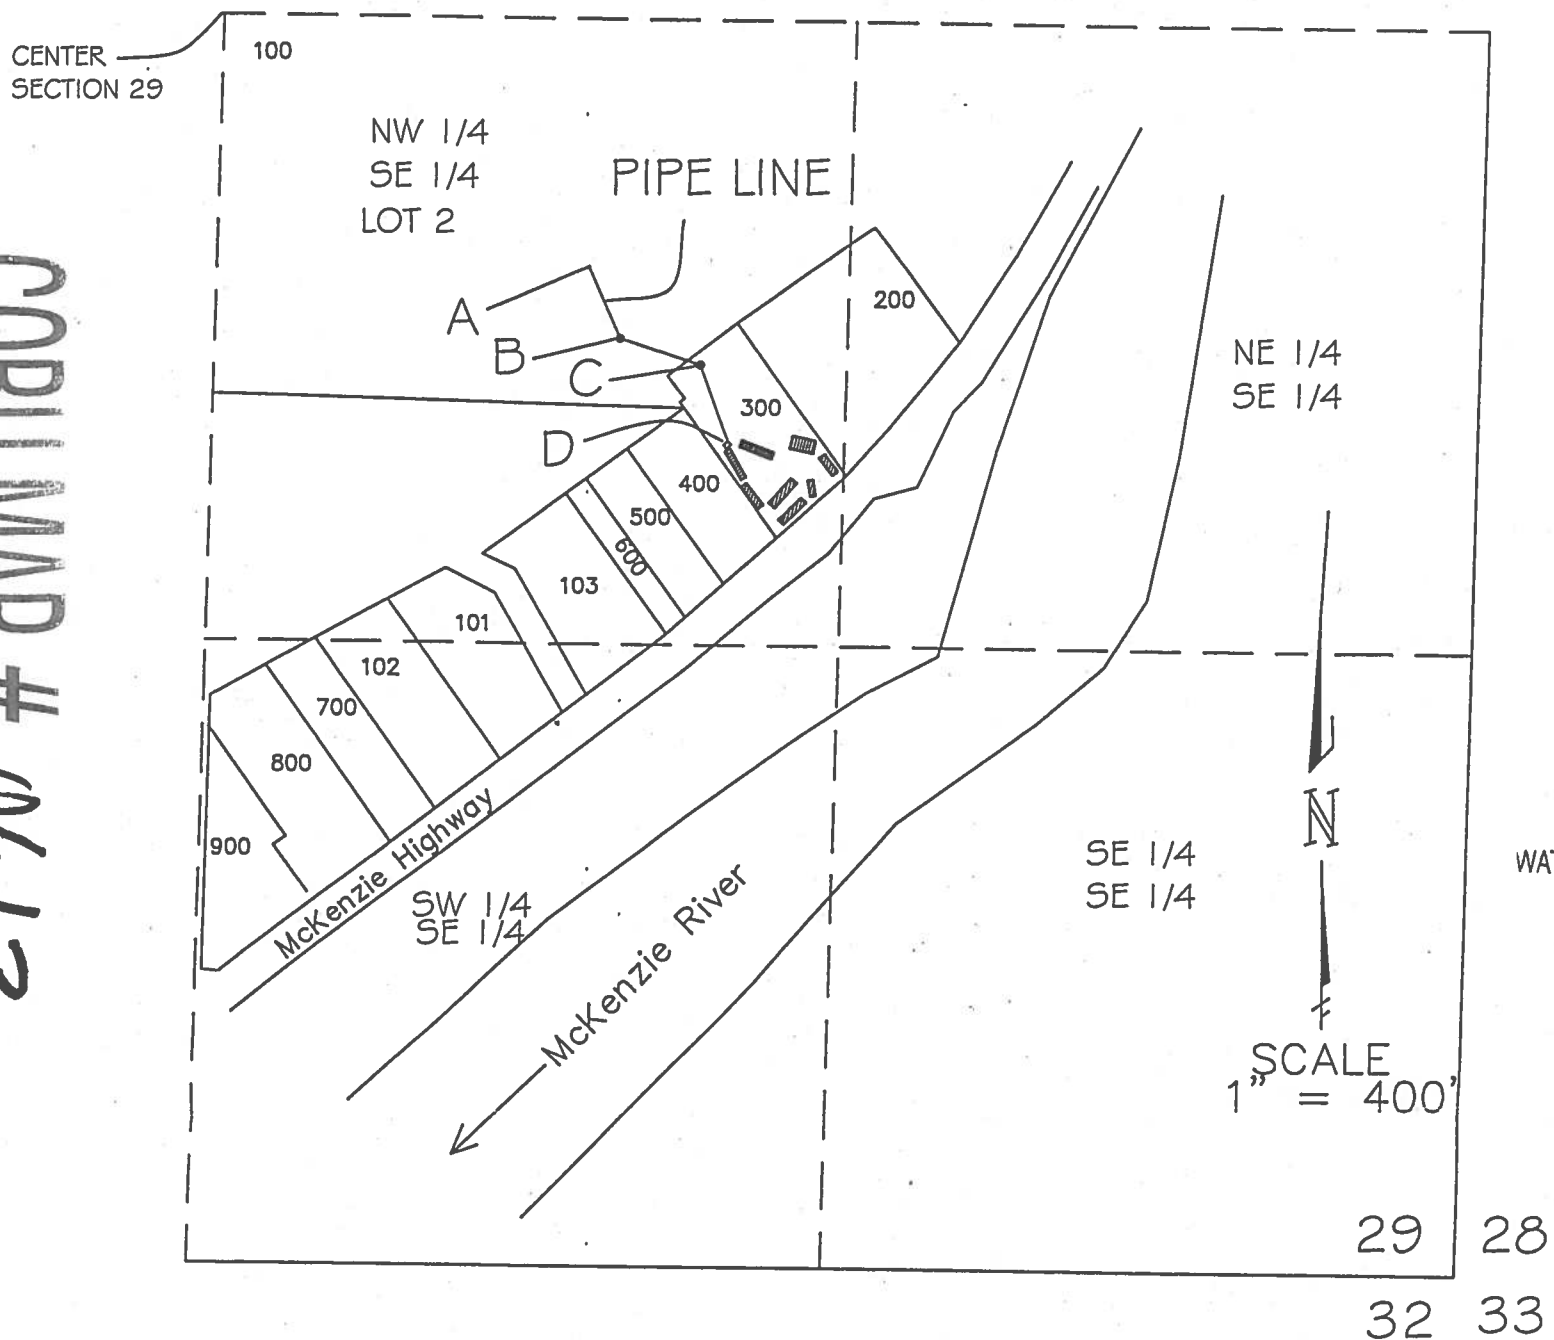

RECEIVED
SEP 20 2011
WATER RESOURCES DEPT
SALEM, OREGON

APPLICATION # S-86462 PERMIT # S-54342

LEGEND:

-  DENOTES MOBILE HOME LOCATIONS
- A DENOTES POINT OF DIVERSION BEING 754.6' SOUTH & 522.3' EAST OF THE CENTER OF SECTION 29
- B DENOTES 500 GAL SETTLING TANK LOCATION
- C DENOTES 1500 GAL WATER RESERVOIR TANK LOCATION
- D DENOTES PARK UV FILTER HOUSE LOCATION (WATER METER LOCATED INSIDE HOUSE)

FINAL PROOF SURVEY
FOR
STEVE R. & DIANA L. SHEFCHECK
90497 MOUNTAIN VIEW LANE
LEABURG, OR. 97489
541-729-0313

BY
H. TIMOTHY FASSBENDER, PLS, CWRE
2896 SARAH LANE
EUGENE, OR. 97408
541-485-3136

NOTE:

THIS MAP IS NOT INTENDED TO PROVIDE
LEGAL DIMENSIONS OR LOCATIONS OF
PROPERTY OWNERSHIP LINES.

