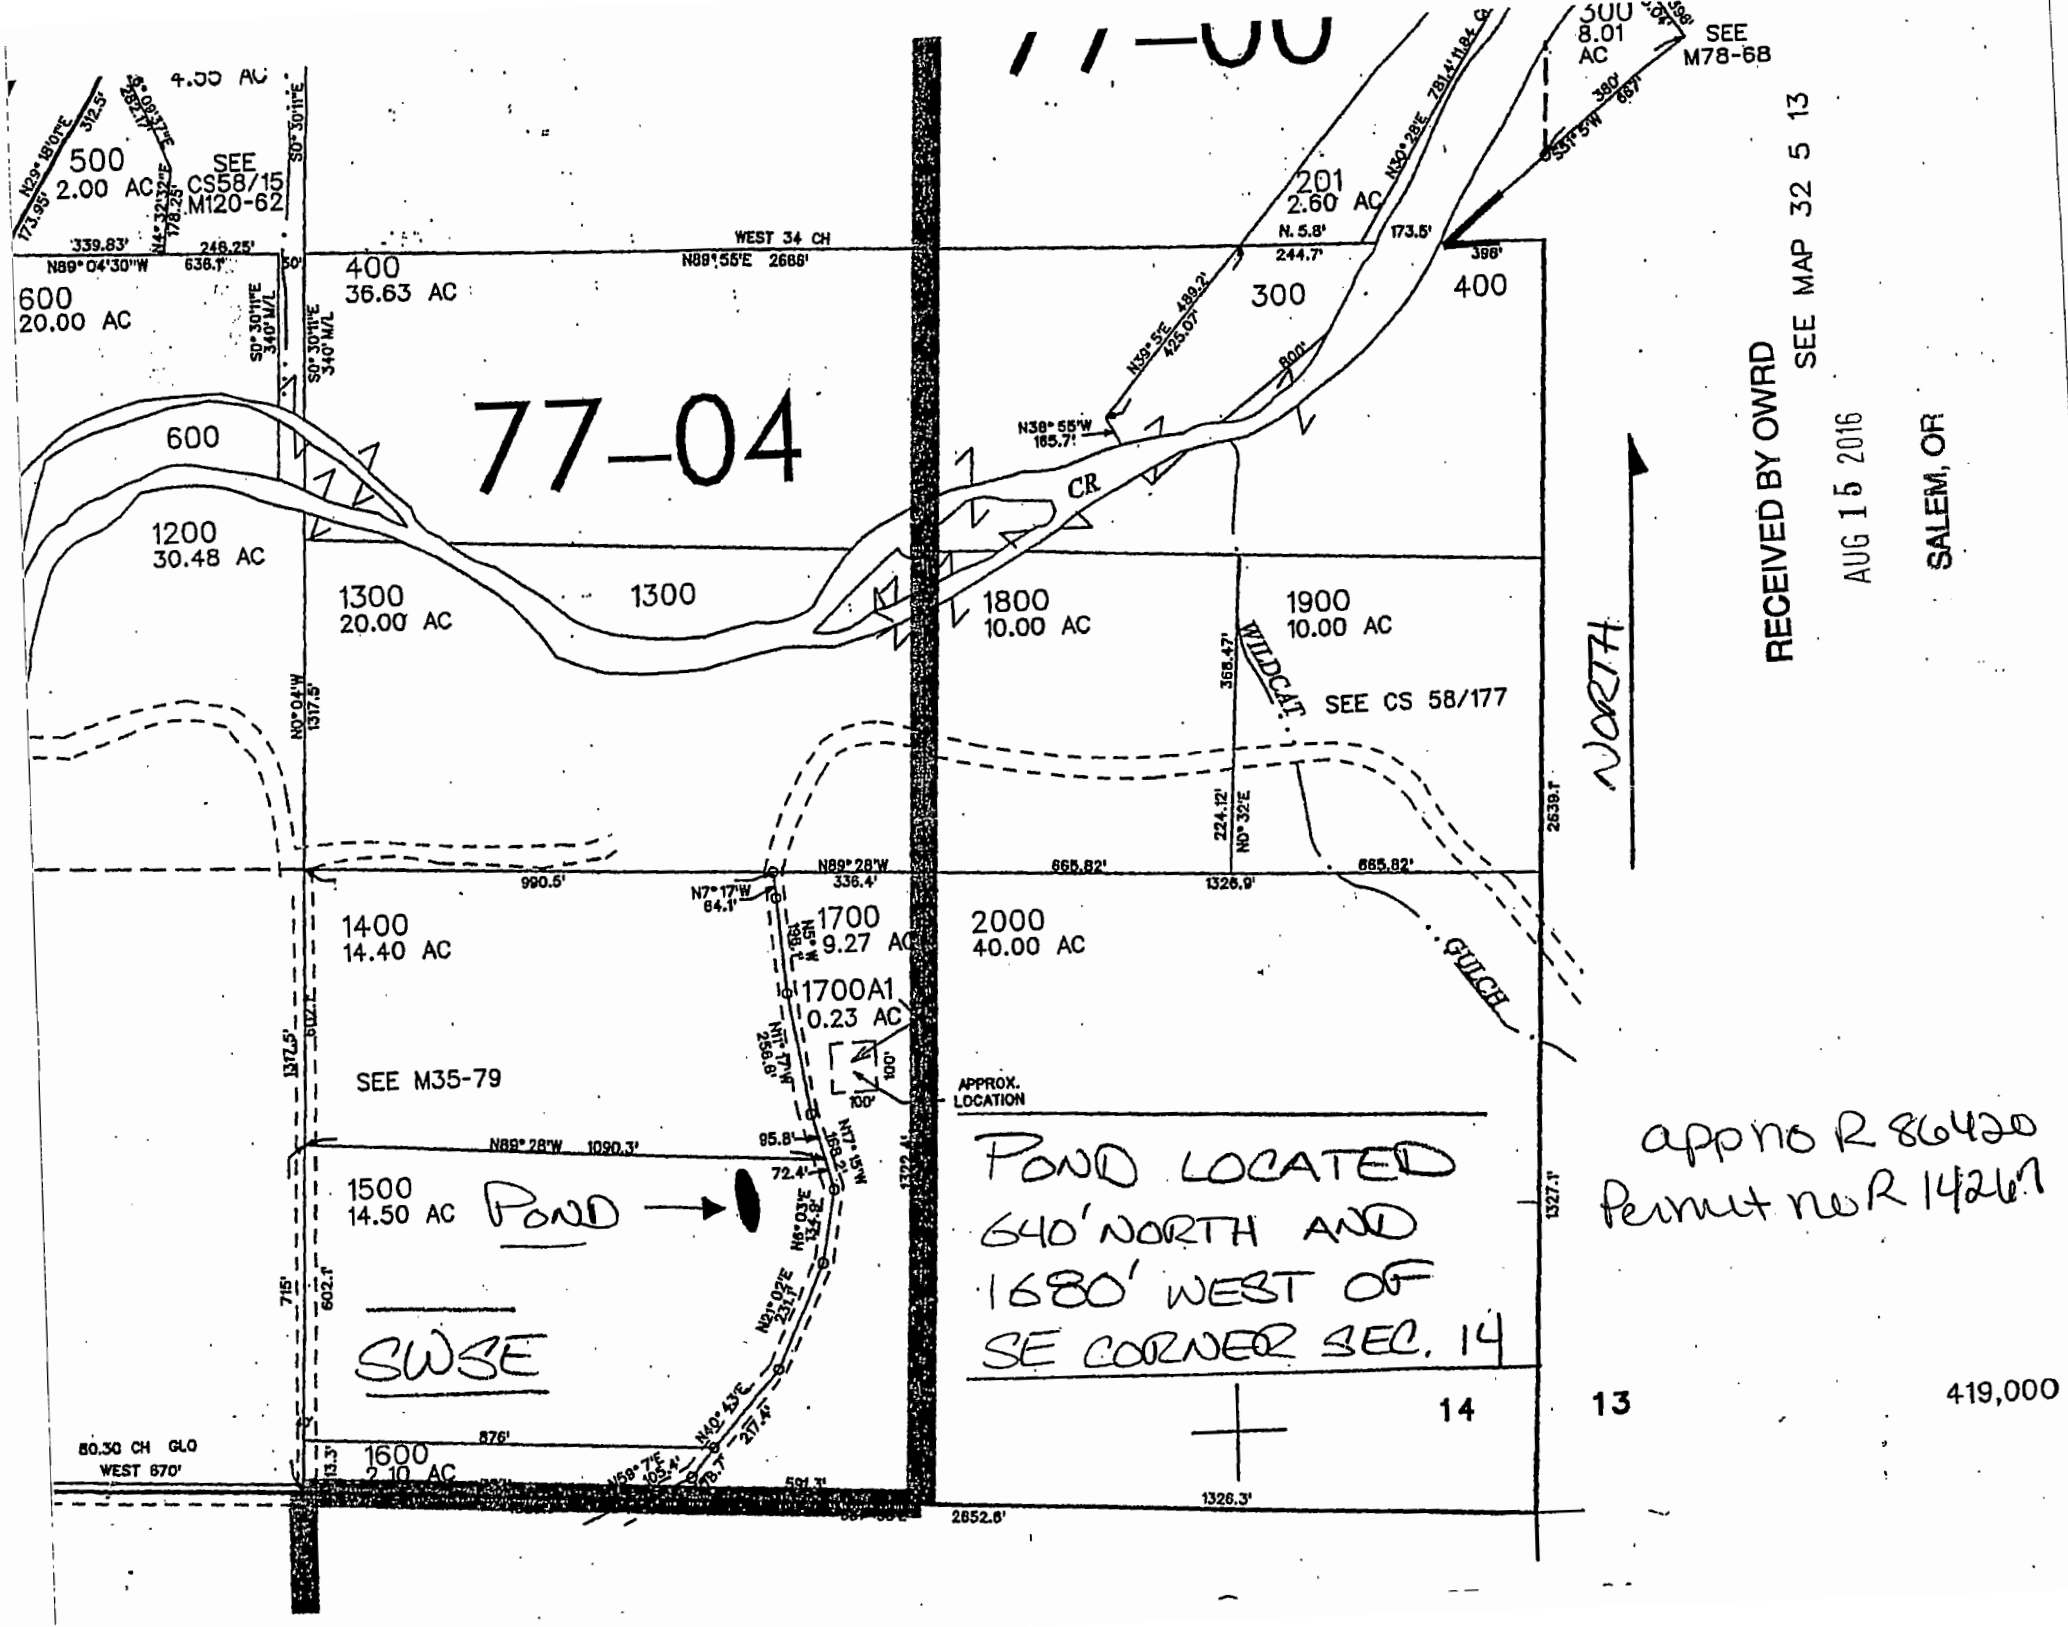

RECEIVED BY OWRD
AUG 15 2016
SALEM, OR

SEE MAP 32 5 13

app no R 86420
Permit no R 14267