


CLAIM OF BENEFICIAL USE MAP UNDER PERMIT G-15391

T. 34 S., R. 6 W., W. M., JOSEPHINE COUNTY

Section 27 NE1/4 SW1/4

September 12, 2007

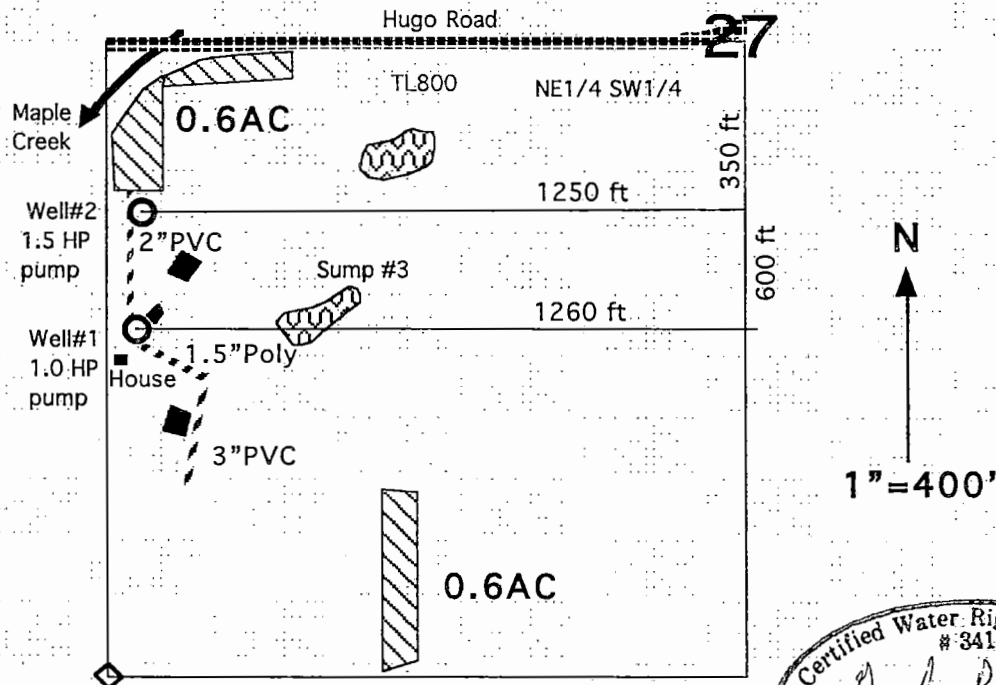

 1.2 acres irrigated from Well #1 and Well #2 with a priority of September 23, 2002 perfected under Application G-15842 and Permit G-15391.

 Points of Appropriation within T34S, R6W, Sec 27, NE1/4SW1/4, TL800.
Well#1 600 feet south and 1260 feet west from the center of section 27.
Well#2 350 feet south and 1250 feet west from the center of section 27.

 Buildings

 Sumps

 Buried pipes

This map was drawn by Gordon R. Lyford for Wayne N. and Janet M. McKy to support their Claim of Beneficial Use of water for irrigation from two wells.
Wayne N. and Janet M. McKy own tax lot 800.

This map was prepared for the purpose of identifying the location of water rights only and is not intended to provide legal dimensions or the location of property ownership lines.