


WATER RIGHT CLAIM OF BENEFICIAL USE MAP  
 FOR  
 SARAH HUCKA  
 LOCATED IN THE  
 SE 1/4 OF SW 1/4 SECTION 28,  
 TOWNSHIP 19 SOUTH, RANGE 1 WEST, W.M.,  
 TAX LOTS 2807, 2808,  
 LANE COUNTY OREGON,  
 APRIL 10, 2012  
 APP # G-16155, PERMIT # G-16008  
 TRANSFER # T-10893, VOL 81, PAGE 815  
 CERTIFICATE #43337

RECEIVED BY OWRP


SALEM, OR

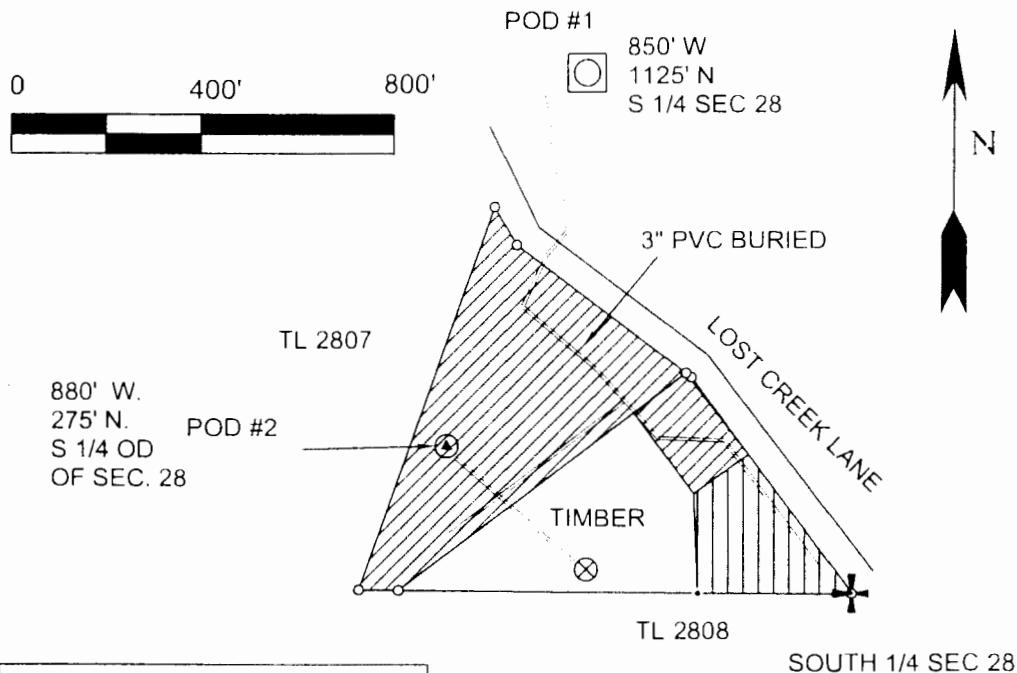

LEGEND	
☐	POD #1
○	PROPERTY CORNER
⊗	RESERVOIR BULGE
⊙	WELL
+	1/4 Corner
+	Tick

- = IRRIGATION PERMIT 5.70 ACRES G-16008
- = TRANSFER T-10893 1.68 ACRES & SUPPLEMENTAL 1.68 ACRES IRRIGATION PERMIT G-16008

DISCLAIMER: THIS MAP IS NOT TO BE USED FOR PROPERTY LOCATION. IT IS FOR WATER RIGHT PURPOSES ONLY.

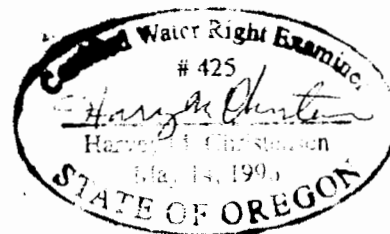

RECEIVED BY OWRP

SALEM, OR