


EXHIBIT B

T29S, R29½E, W.M.
Harney County, Oregon

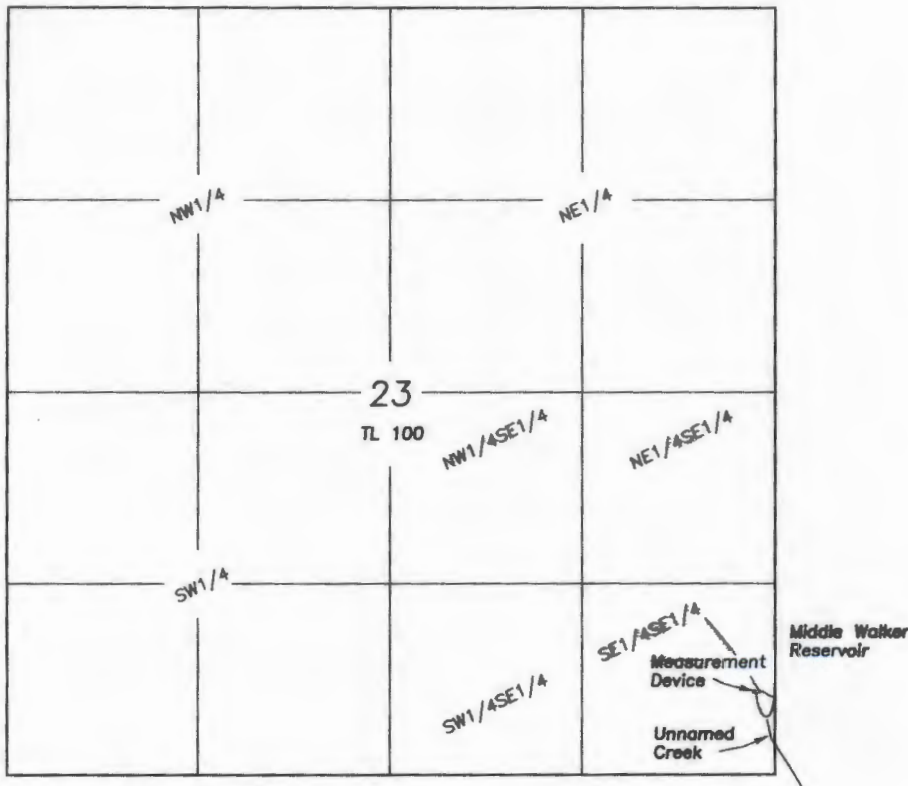

Outlet is located 580' North & 140' West of the
SE corner of Section 23.

Measuring device is located 3' North & 10' West of the Outlet.

FINAL PROOF SURVEY
CLAIM OF BENEFICIAL USE
MIDDLE WALKER RESERVOIR

For

Bureau of Land Management

November 17, 2016

LEGEND

Application No. R-59663
Permit No. R-8095
Priority 12/21/1979

A portion of Tax Lot
29-29V TL100

NOTE: Tax Lot 100 is owned by the BLM
and is more that 23,000 acres.
No boundaries of the tax lot
can be shown.

Prepared by
Cornerstone Surveying, Inc

P.O. BOX 33
JOHN DAY, OR. 97845
(541)575-1813

cornerstonesurvey@centurytel.net

RECEIVED BY OWRD

FEB 06 2017

SALEM, OR

NOTE: The preparation of this map
was for the purpose of identifying
the location of the proposed water
right and has no intent to provide
dimensions or location of property
ownership lines.

