



T.18S. R.8E. Section 29, W.M.

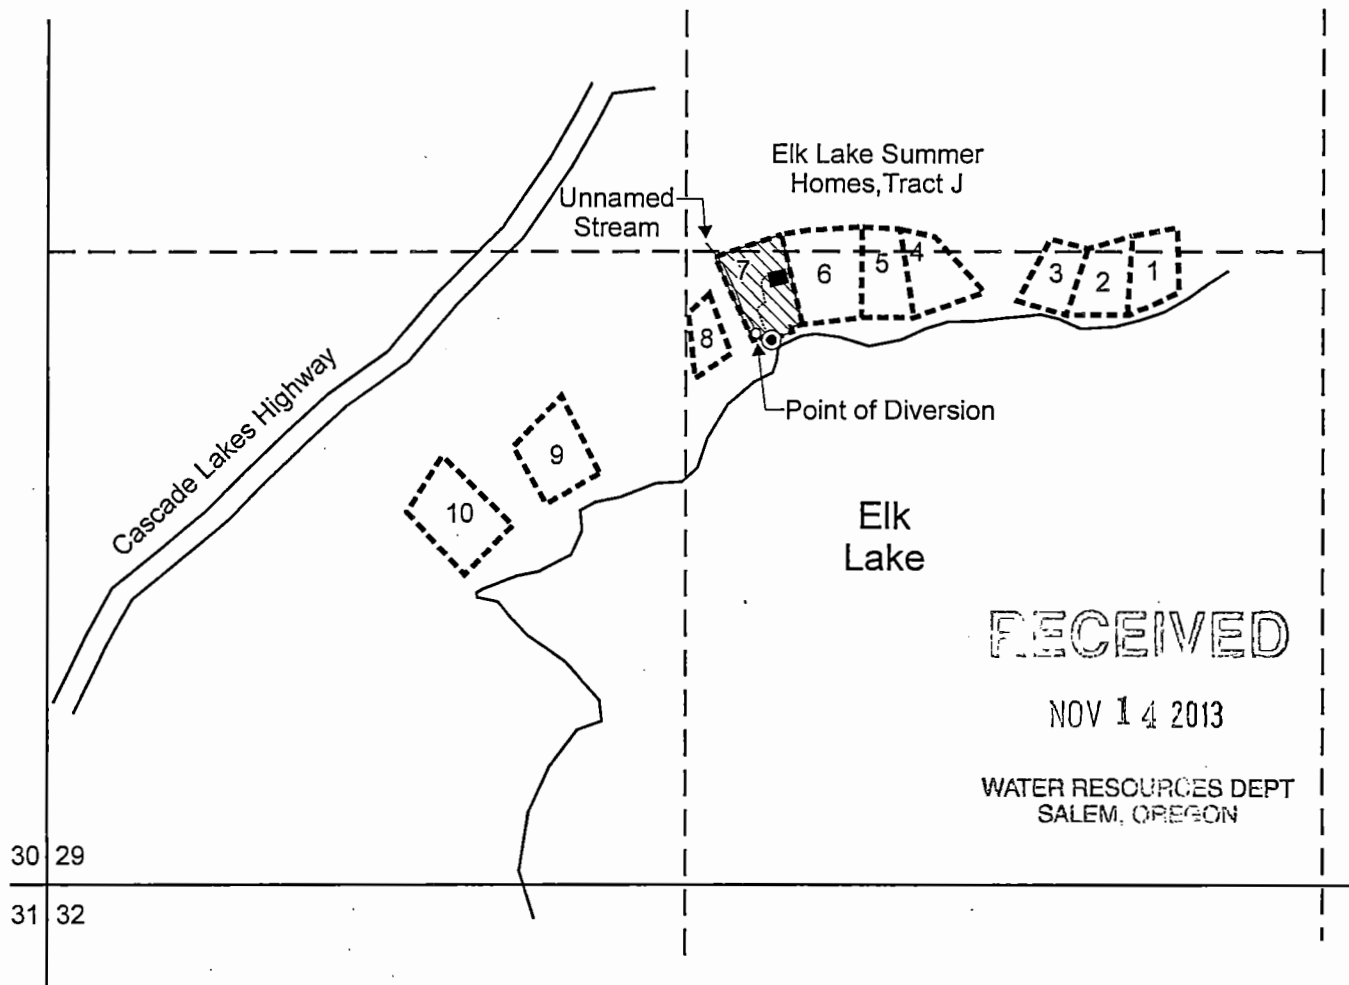


Point of Diversion is located 1,150 feet north and 1,470 feet east from the SW corner, Section 29.

- Area of use for Human Consumption.
- Tax lot boundary
- Cabin Location
- Pump Location
- Meter Location
- Mainline

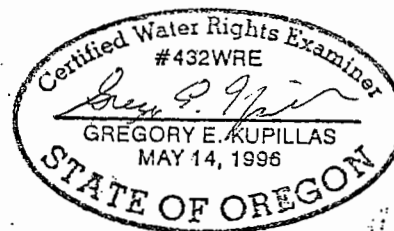


EXPIRATION DATE: 6/30/2015

Scale: 1" = 400'

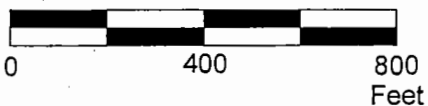

This map was prepared for the purpose of identifying the location of a water right only and is not intended to provide legal dimensions or location of property ownership lines.

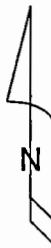

Pacific Hydro-Geology Inc.

Claim of Beneficial Use Map
Application S-87300, Permit S-54731
Elk Lake - Kenneth and Christine Emmes
T.18S. R.8E. Section 29, W.M.

07/2011