


CLAIM OF BENEFICIAL USE
FOR RESERVOIR
FOR SUSAN APPELGATE
BY DUANE W. KIRBY
APPLICATION NO R72477
PERMIT NO R12506
T 22S & 23S R 4W WM
SEC 31,32,5,6

RECEIVED BY OWRD

NOV 04 2013

SALEM, OR

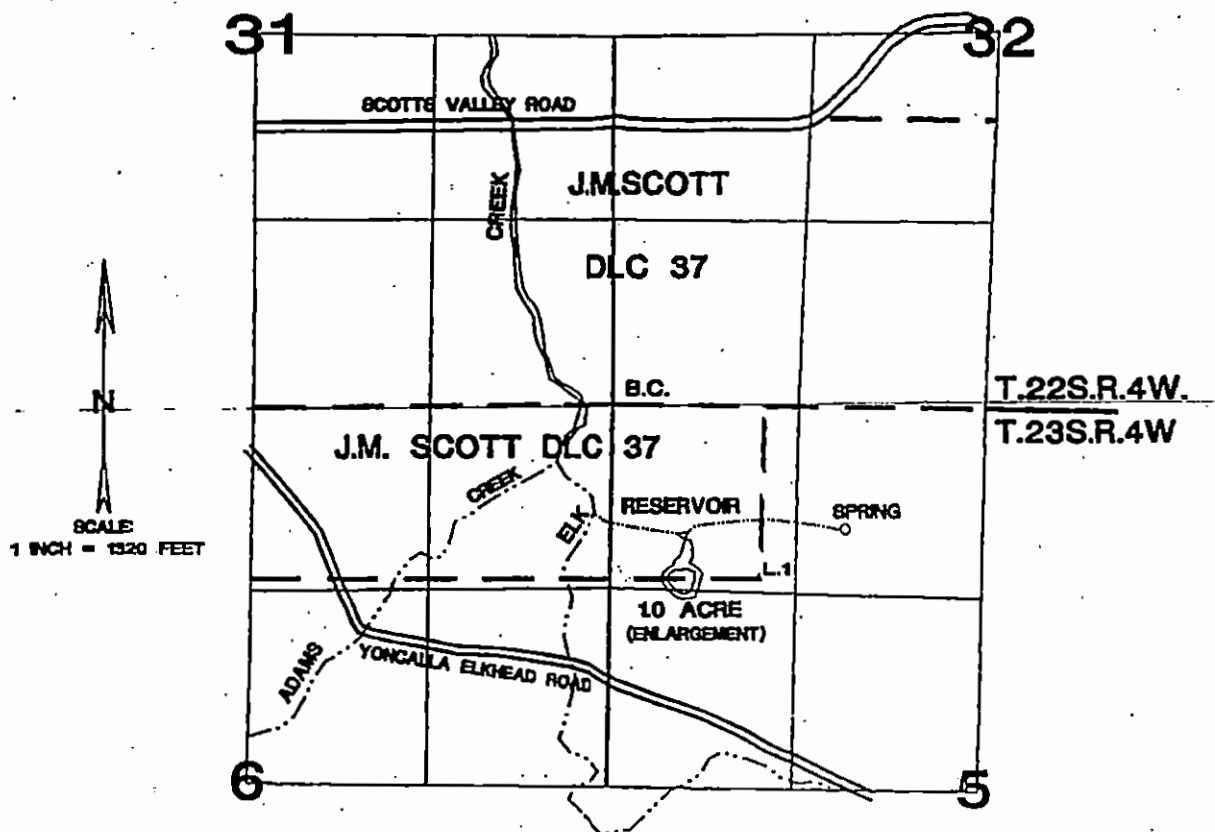

SPRING IS LOCATED 850' S. & 1850' E. FROM NW CORNER SEC. 5.
RESERVOIR IS LOCATED 1100' S. & 550' E. FROM NW CORNER OF SEC. 5.

THE PURPOSE OF THIS MAP IS TO IDENTIFY
THE LOCATION OF THE WATER RIGHT. IT IS
NOT INTENDED TO PROVIDE INFORMATION
RELATIVE TO THE LOCATION OF PROPERTY
OWNERSHIP BOUNDARY LINES.



TL 23-4-5-400
HC WRP
12/11/13