


NOTE:
THE POINT OF DIVERSION AND FOUND
MONUMENT WERE LOCATED USING A
TRIMBLE TSC3 DATA COLLECTOR WITH
INTERNAL GPS. THIS MAP WAS CREATED
USING RECORD COOS COUNTY SURVEYS;
ORIGINAL PLAT BOOK 9-7 NORTH LAKE
ESTATES AND CS#55B34.

NW1/4
SW1/4

SECTION LINE

NE1/4
SW1/4

**LOT 13, BLOCK 1, NORTH
LAKE ESTATES PLAT NO.
1, IN THE SE1/4 SW1/4,
SEC. 4, T.23S., R.12W., W.M.,
COOS COUNTY, OREGON**

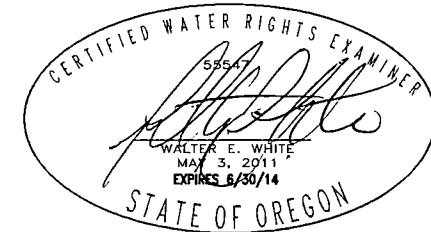

DISCLAIMER:
THIS MAP IS NOT INTENDED TO PROVIDE
LEGAL DIMENSIONS OR LOCATIONS OF
PROPERTY OWNERSHIP LINES.

RECEIVED BY OWRD

OCT 23 2013



SALEM, OR

SW1/4
SW1/4

N29°59'00"E 621'



SCALE: 1"=400'

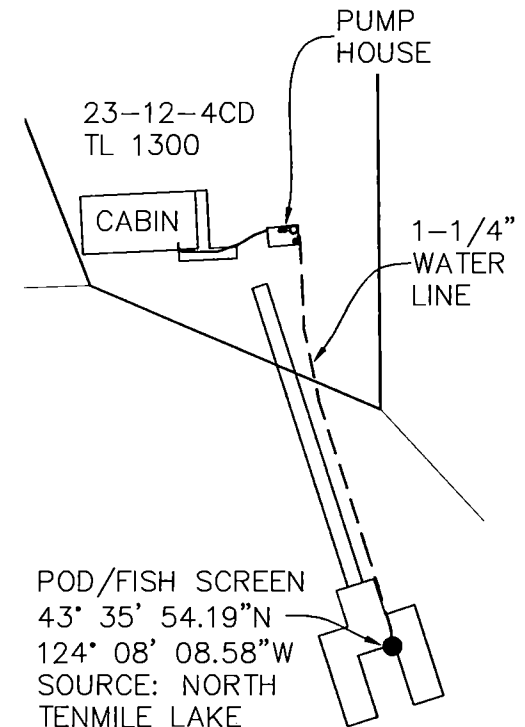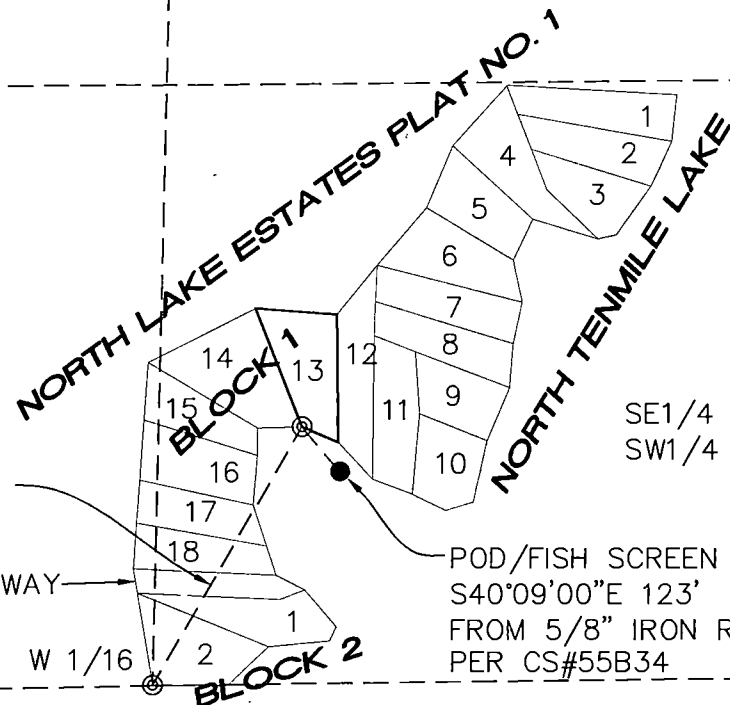

SCALE: 1"=50'

SEW
Consulting Engineers
& Geologists, Inc.

CLIENT
PROJECT
LOCATION

TITLE1
TITLE2
PROJ#

DATE

FILENAME

FigureFIG#