


APPLICATION	R-73607	PERMIT	R-11899
APPLICATION	R-73608	PERMIT	R-11896
APPLICATION	S-73609	PERMIT	S-52556

RECEIVED

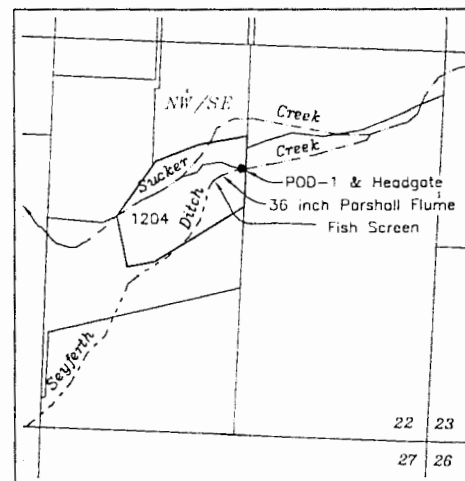

NORTH

Scale

$$1 \text{ inch} = \frac{1}{1320} \text{ feet}$$

Point of diversion (POD-1) - 1820 feet
north & 1330 feet west from the
SE corner of section 22

Point of diversion (POD-2) – Pump & Dam
350 feet north & 330 feet west from the
E 1/4 corner of section 33


Point of diversion (POD-3) -12 inch Outlet
450 feet ~~north~~^{south} & 2570 feet east from the
W 1/4 corner of section 34

South Pond Spillway - 160 feet north &
90 feet west from the E 1/4 corner of
section 33

South Pond Dam - 120 feet south & 310 west
from the E 1/4 corner of section 33

Base map - Josephine County GIS tax lots
overlaid on 2005 FSA aerial photo for assumed best fit

This map is not intended to provide legal dimensions
or locations of property ownership lines

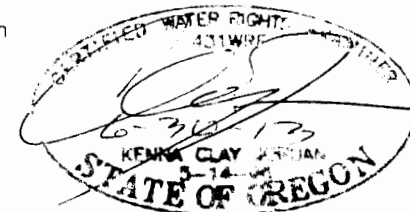

JORDAN ENGINEERING
460 JORDAN LANE
ROSEBURG, OR 97471
(541) 673-1931

Revision-2 8/20/2011 n.e.d.

 Agricultural Use / Frost Protection

N - North Pond 5.0 A.F. } Aesthetics, Frost
S - South Pond 6.5 A.F. } Control

U - Unnamed Res 7.0 A.F. - Agricultural Use
(Frost Protection)

----- Ditch

Figure 1. Pipeline

Driveway

WRD revised map to reflect 450' SOUTH, for POD 3. mb/wrd 12-6-16