


T. 13 S., R. 33 E., W.M.

RECEIVED

APR 25 1994

WATER RESOURCES DEPT.
SALEM, OREGON

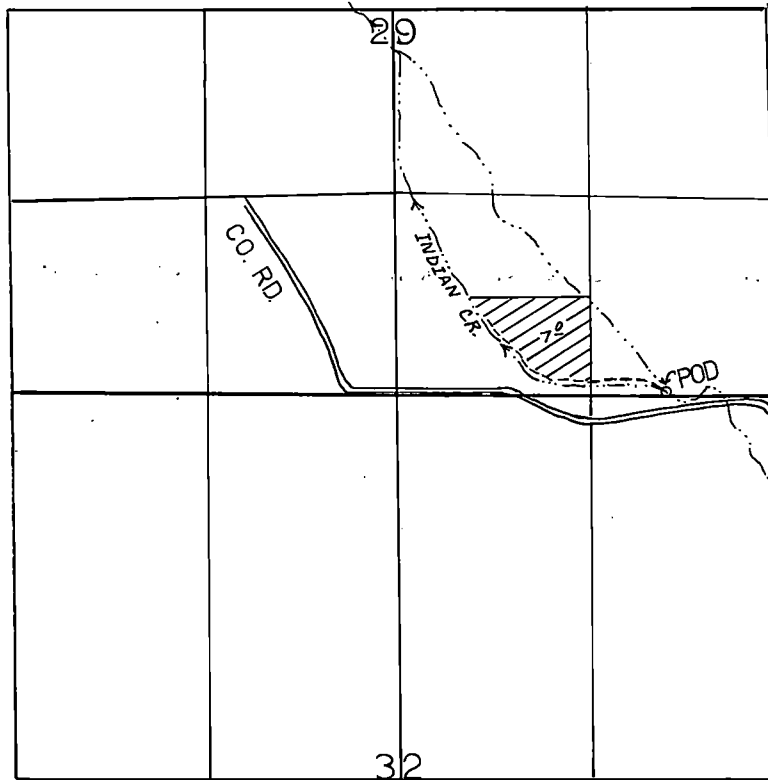

1" = 1320'

POD - 10' N. AND 750' W. FROM THE S.E. COR. SEC. 29.

FINAL PROOF SURVEY

UNDER

TRANSFER 5349

IN NAME OF

RAYMOND H. AND GAIL M. POTTER

Surveyed 3-16, 1986, by L. TOLL