

585

CLAIM OF BENEFICIAL USE FOR
WILLIAM EBERT & CHARLENE RENNE
IN NW1/4 OF NE1/4, SECTION 10

T. 33 S., R. 15 W., W.M.
CURRY COUNTY, OREGON


APPLICATION #S-72989

PERMIT #52123

RECEIVED

MAY 16 2011


WATER RESOURCES DEPT
SALEM, OREGON

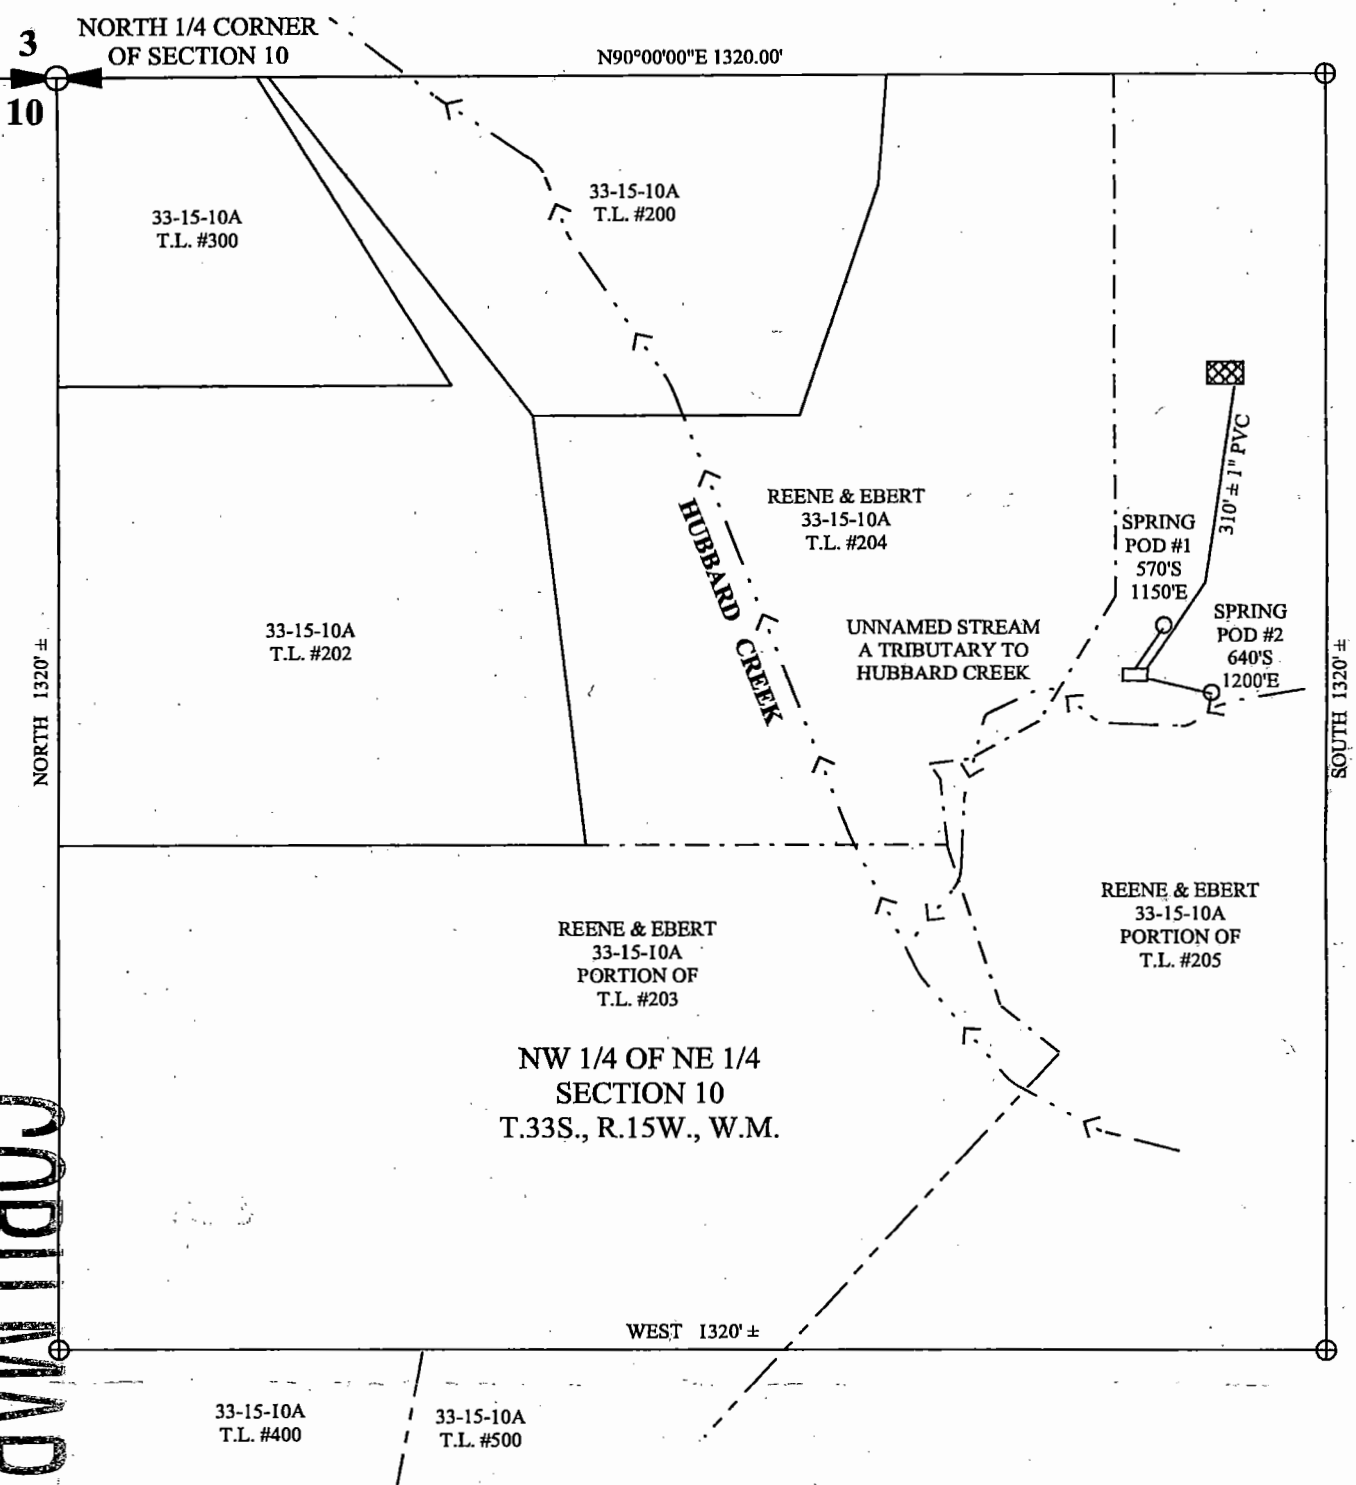

THIS MAP IS NOT INTENDED TO PROVIDE LEGAL
DIMENSIONS OR LOCATION OF PROPERTY OWNERSHIP LINES.

LEGEND

- POINTS OF DIVERSION
- ⊕ NORTH 1/4 CORNER, SEC. 10
- 1500 GALLON PLASTIC TANK/RESEVOIR WITH SUBMERSIBLE PUMP INSIDE
- ▣ HOUSE WITH ATTACHED SHED CONTAINING A 50 GALLON PRESSURE TANK WM-9 WELLMATE #175110

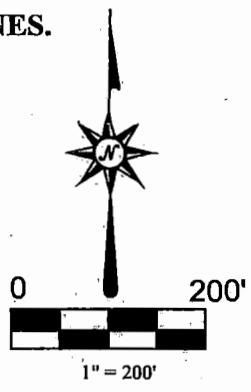

FLAVIN LAND SURVEYING
32053 CEDAR VALLEY ROAD
GOLD BEACH, OREGON 9744
541-247-6485

EXPIRES 12/31/11

CORRECTION MAP # 0585