
Township: 65
Range: 6W
Section: 31

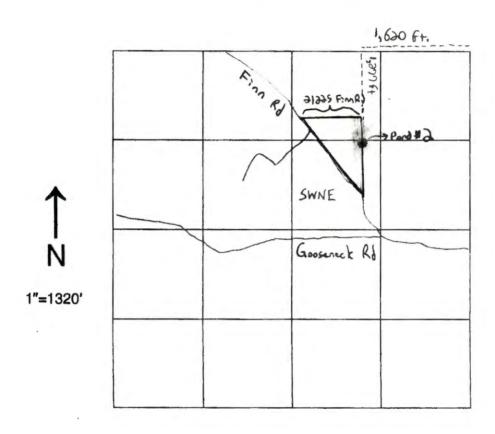

Applicant:	Chris	Rentzel	/Agent: Ollie	Collins
Application #:		Permit #:	Age and	



OWRD