

ROW RIVER

T.20S.,R.2W.,W.M. SEC. 31 & 32

T.21S.,R.2W.,W.M. SEC. 5 & 6

KELLY D.L.C. 38 & COLE D.L.C. 39

CLAIM OF BENEFICIAL USE

DIVERSION POINT,
FISH SCREEN
& FLOWMETER
3280' NORTH & 210'
WEST FROM THE S.E.
CORNER OF SECTION
31.

THIS MAP IS NOT
INTENDED TO
PROVIDE LEGAL
DIMENSIONS OR
LOCATION OF
PROPERTY LINES.

FOR: U.S. DEPT. OF AGRICULTURE
UMPQUA NATIONAL FOREST

TRANSFER No. T-11005

LANE COUNTY, OREGON

MAP# 21-02-06 - ALL IN 'IT.# 1700

PRIORITY DATE: 4-4-1963

ORIGINAL CERTIFICATE No. 34613

PERMIT No. S28741



COLE D.L.C. 39
KELLY D.L.C. 38

SHOREVIEW ROAD
IRRIGATION PIPELINE

DLC 39
S.31NESE
6.00 A

DLC 39
S.32NWSW
11.94 A

DLC 38
S.32NWSW
0.38 A

DLC 38
S.32NESW
2.31 A



IRRIGATED ACRES
C-86678 (82.2 AC)



WATER PIPELINE



T-11005 (CF) (19.1 AC)

RECEIVED BY OWRD

SEP 18 2012

SALEM, OR

DLC 39
S.32SWSW
~~22.7 A~~
2.84 (CF)
19.86 (C-86678)

DLC 38
S.32SWSW
~~5.62 A~~
3.79 (CF)
1.83 (C-86678)

DLC 38
S.32SESW
~~22.37 A~~
11.37 (CF)
11.0 (C-86678)

DLC 39
S.31SESE
14.96 A

S31 S32

S6 S5

DLC 39
S.6NENE
5.56 A

DLC 39
S.5NWNW
8.36 A

DLC 38
S.5NENW
4.10 A
1.10 (CF)

SURVEYED 8/25/09 BY:

DONN ROWE LLC


(541) 953-7778

90946 SUNDERMAN ROAD

SPRINGFIELD, OR. 97478



Scale: 1 inch = 400 feet

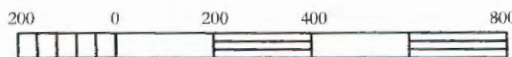

WRD has updated this map to reflect both the confirming (CF) portion of transfer T-11005 (19.1 AC), and the remaining right Certificate 86678 (82.2 AC). MFB/WRD 4/5/17 MSB