



T.6N., R.35E., W.M.

T0
E 1/2

SEC. 35

Sunnyside-Umapine Road

1
2
3
4
5
6
7
8
9
10
11
12

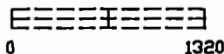
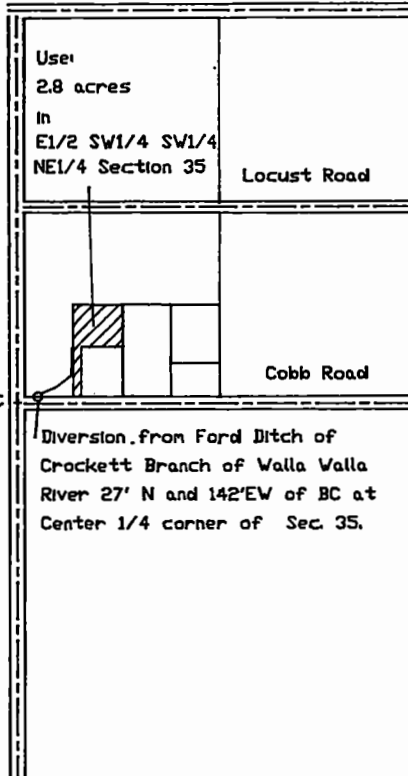


Scale: 1"=1320'


OWNER:
City of Milton-Freewater
City Hall
722 S. Main
Milton-Freewater
OR 97862
(503) 938-5531

Survey By:
CVRE 300
(renews 6-30-99)
David Haddock
P. O. Box 1574
Pendleton, OR 97801
(541)276-2174
Survey - July 1994
Revised November 1997

1" pvc lateral lines

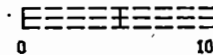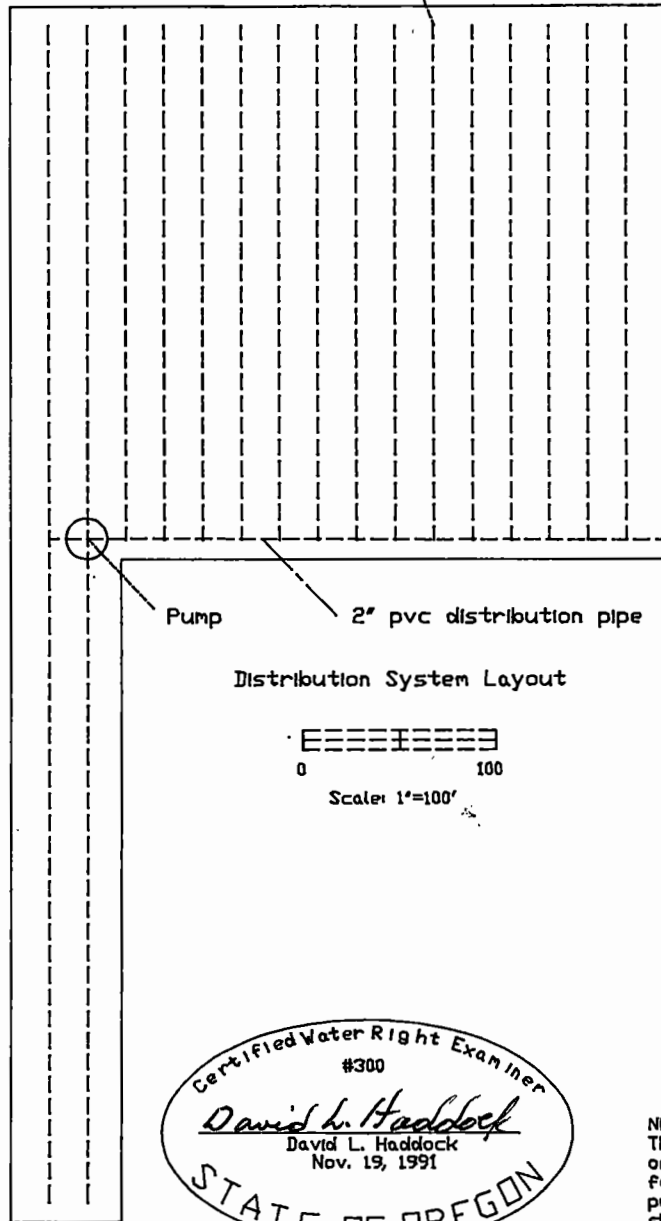

Scale: 1"=100'

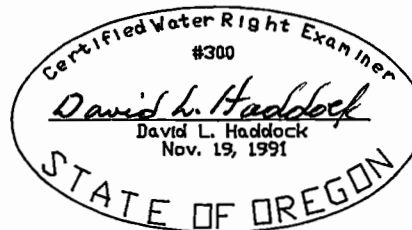

NOTE:
The information shown on this map is solely for Water Rights purposes. The data shown does not represent ownership information.