

LEGEND

- USGS GRID
- GOV LOT
- TAXLOT LINE
- ROADWAY
- 1-1/2" PE PIPING
- [M] WATER METER
- ◆ SECTION CORNER

RECEIVED T. 2S. R10W., W.M.

JAN 31 2013

Thomas Swanson

SECTION 30

T. 2 S, R. 10 W, W.M.

TILLAMOOK COUNTY

WATER RESOURCES DEPT 11545 WHISKEY CREEK ROAD
SALEM, OREGON TILLAMOOK, OR 97141

SCALE: 1" = 400'

NETARTS
BAY

NENW

LOT 1

NWNE

NENE

TL 200

TL 301

TL 300

TL 400

TL 100

SENE

SWNE

SENE

1100-GAL
PE TANK

P.O.D.


NOTES:

POD IS 545 FT. NORTH AND 925 FT. WEST
FROM EAST 1/4 CORNER OF SECTION 30

PREPARATION OF THIS MAP IS FOR THE PURPOSE
OF IDENTIFYING THE LOCATION OF THE WATER
RIGHT ONLY. THERE IS NO INTENT TO PROVIDE
DIMENSIONS OR LOCATION OF PROPERTY
OWNERSHIP LINES.

POINT OF
BEGINNING
OF SURVEY

E 1/4 COR

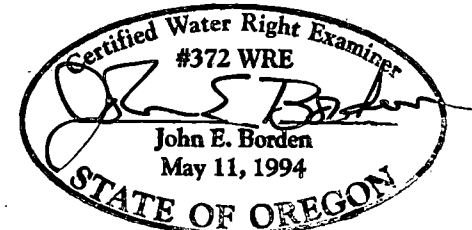

Exp: 12/31/2013

Survey

AND CLAIM OF BENEFICIAL USE
UNDER

APPLICATION No. S-87252,

PERMIT No. S-54593

IN THE NAME OF
THOMAS SWANSON

FOR

HUMAN CONSUMPTION FOR 3 HOUSEHOLDS

FROM HATHAWAY CREEK,
TRIBUTARY TO NETARTS BAY,

SURVEYED OCTOBER 25, 2012

BY JOHN E. BORDEN, CWRE

Thomas Swanson Water Right

FILE PATH & NAME: J:\JD\SWANSON\SWANSON_COBU_012113.DWG

5597 RIVER STREET
WEST LINN, OR. 97008
503-723-4257

JOHN BORDEN CONSULTING