

CLAIM OF BENEFICIAL USE MAP

LOCATED IN THE SW 1/4 OF THE SW 1/4
OF SECTION 9, TOWNSHIP 23 SOUTH, RANGE 12 WEST, W.M.
COOS COUNTY, OREGON
APPLICATION S-81203, PERMIT S-53127



DATE: JANUARY 22, 2013

SURVEY METHOD:


THE P.O.D. WAS TIED BY CONVENTIONAL TOTAL STATION
TRAVERSE TO THE CENTER-SOUTH 1/16 CORNER.

NOTE:

THE POINT OF DIVERSION IS LOCATED 250 FEET
SOUTH AND 1754 FEET WEST OF THE
CENTER-SOUTH 1/16 CORNER OF SECTION 9,
T.23S., R.12W., W.M.



NW1/4 SW1/4
SW1/4 SW1/4

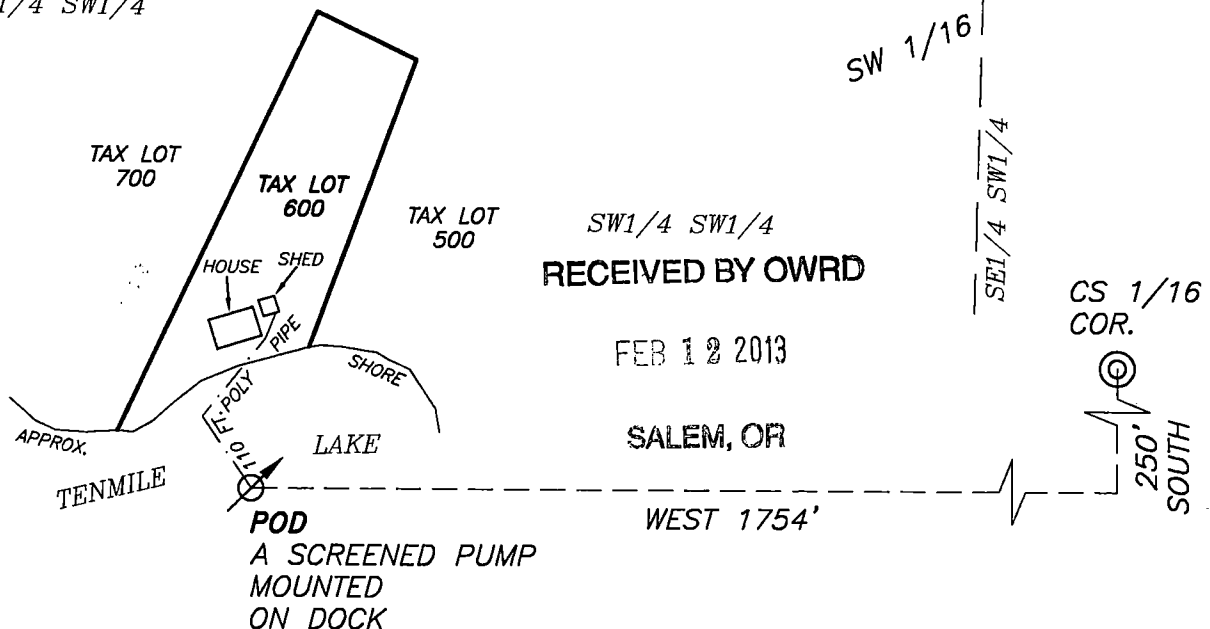


LEGEND

POINT OF BEGINNING

POINT OF DIVERSION

SCALE 1" = 100 FT.

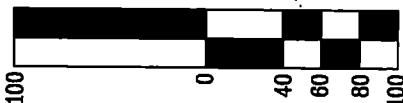

EXAMINER'S DISCLAIMER STATEMENT

THE PREPARATION OF THIS MAP WAS FOR THE PURPOSE OF
IDENTIFYING THE LOCATION OF THE WATER RIGHT ONLY AND
HAS NO INTENT TO PROVIDE DIMENSIONS OR LOCATION OF
PROPERTY OWNERSHIP LINES.



705 S. 4TH ST.
P.O. BOX 118
COOS BAY, OREGON 97420

PHONE: (541) 267-2872
FAX: (541) 267-0588
www.stuntzner.com

Engineering - Land Surveying - Forestry - Land Planning - Water Rights

JOB #: 113-008

DATE: January 2013

DRAWN BY: CMW

CHECKED BY: DRG

PREPARED

FOR:

James Henson

3170 SW Binford Lk. Pkwy.
Gresham, OR

FILE NAME: 113-008 Henson COBU.dwg

SHEET 1 OF 1