

TOWNSHIP 2 NORTH
RANGE 2 WEST, W.M.

TOWNSHIP 2 NORTH,
RANGE 1 WEST, W.M.

CLAIM OF BENEFICIAL USE MAP

PERMIT NUMBER: R-84711/R-13162

RECEIVED BY OWRD

AUG 30 2012

SALEM, OR

LEGEND



SECTION CORNER



OUTLET STRUCTURE



AREAS SUBMERGED BY RESERVOIR




EXISTING WATERCOURSE / INUNDATED AREAS



PROPERTY / LOT LINES

THIS MAP WAS PREPARED FOR:
METRO PARKS AND GREENSPACES
600 NE GRAND AVE
PORTLAND, OREGON 97232
ON JUNE 22ND, 2012

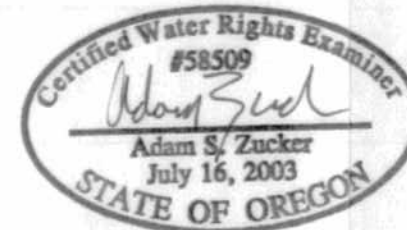

Expiration Date: 6-30-2014



SCALE: 1" = 1320'

THIS MAP WAS PREPARED FOR THE PURPOSE OF IDENTIFYING THE LOCATION OF A WATER RIGHT ONLY AND IS NOT INTENDED TO PROVIDE LEGAL DIMENSIONS OR LOCATION OF PROPERTY OWNERSHIP LINES.

COBU MAP # 701

701

