


CLAIM OF BENEFICIAL USE MAP
FOR DAVID OTTERBACH
LOCATED IN THE SE1/4 OF THE SW1/4 AND THE SW1/4 OF THE SE1/4 OF SECTION 17,
TOWNSHIP 23 SOUTH, RANGE 12 WEST, W.M.,
COOS COUNTY, OREGON

APPLICATION #S-80867
PERMIT #52594

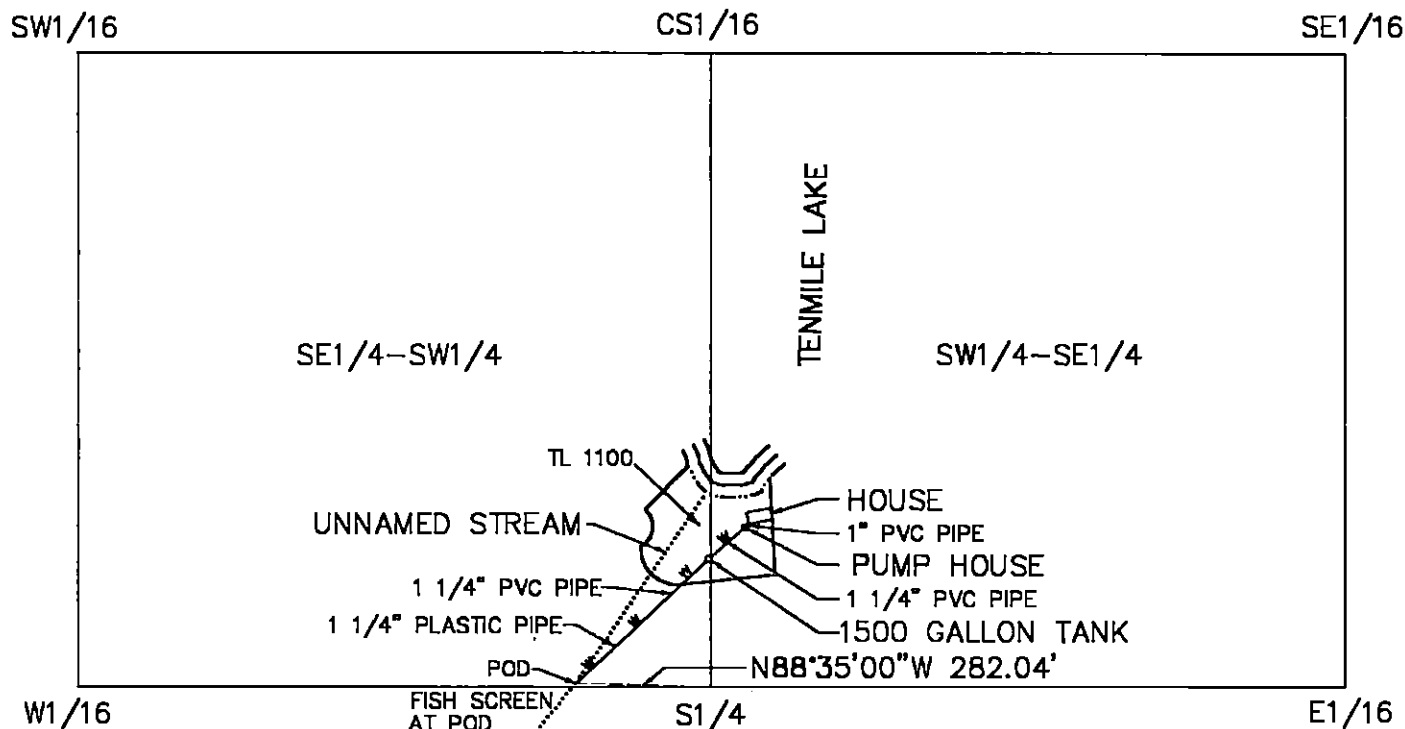


LEGEND:

POD POINT OF DIVERSION

TL TAX LOT

— W — WATER PIPE LINE

..... UNNAMED STREAM

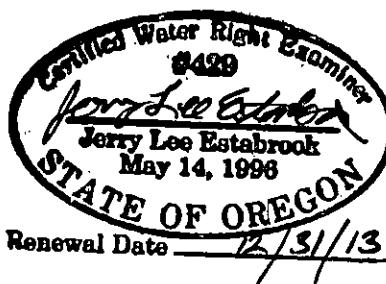

RECEIVED BY OWRD

JAN 24 2013

SALEM, OR

EXAMINERS DISCLAIMER STATEMENT:

THE PREPARATION OF THIS MAP WAS FOR THE PURPOSE OF IDENTIFYING THE LOCATION OF WATER RIGHT ONLY AND HAS NO INTENT TO PROVIDE DIMENSIONS OR LOCATION OF PROPERTY OWNERSHIP LINES.

SCALE 1" = 400'