


CLAIM OF BENEFICIAL USE
 FOR ALFRED G. AND LORENE M. DAHL
 BY DUANE W. KIRBY
 T29S, R7W, W.M., SEC 3
 TAX LOT 500

APPLICATION NO. S-83749
 PERMIT NO. S-53514

FISH SCREEN LOCATED AT POD
 METER IS LOCATED 10 FEET FROM PUMP
 SCALE 1" = 400'

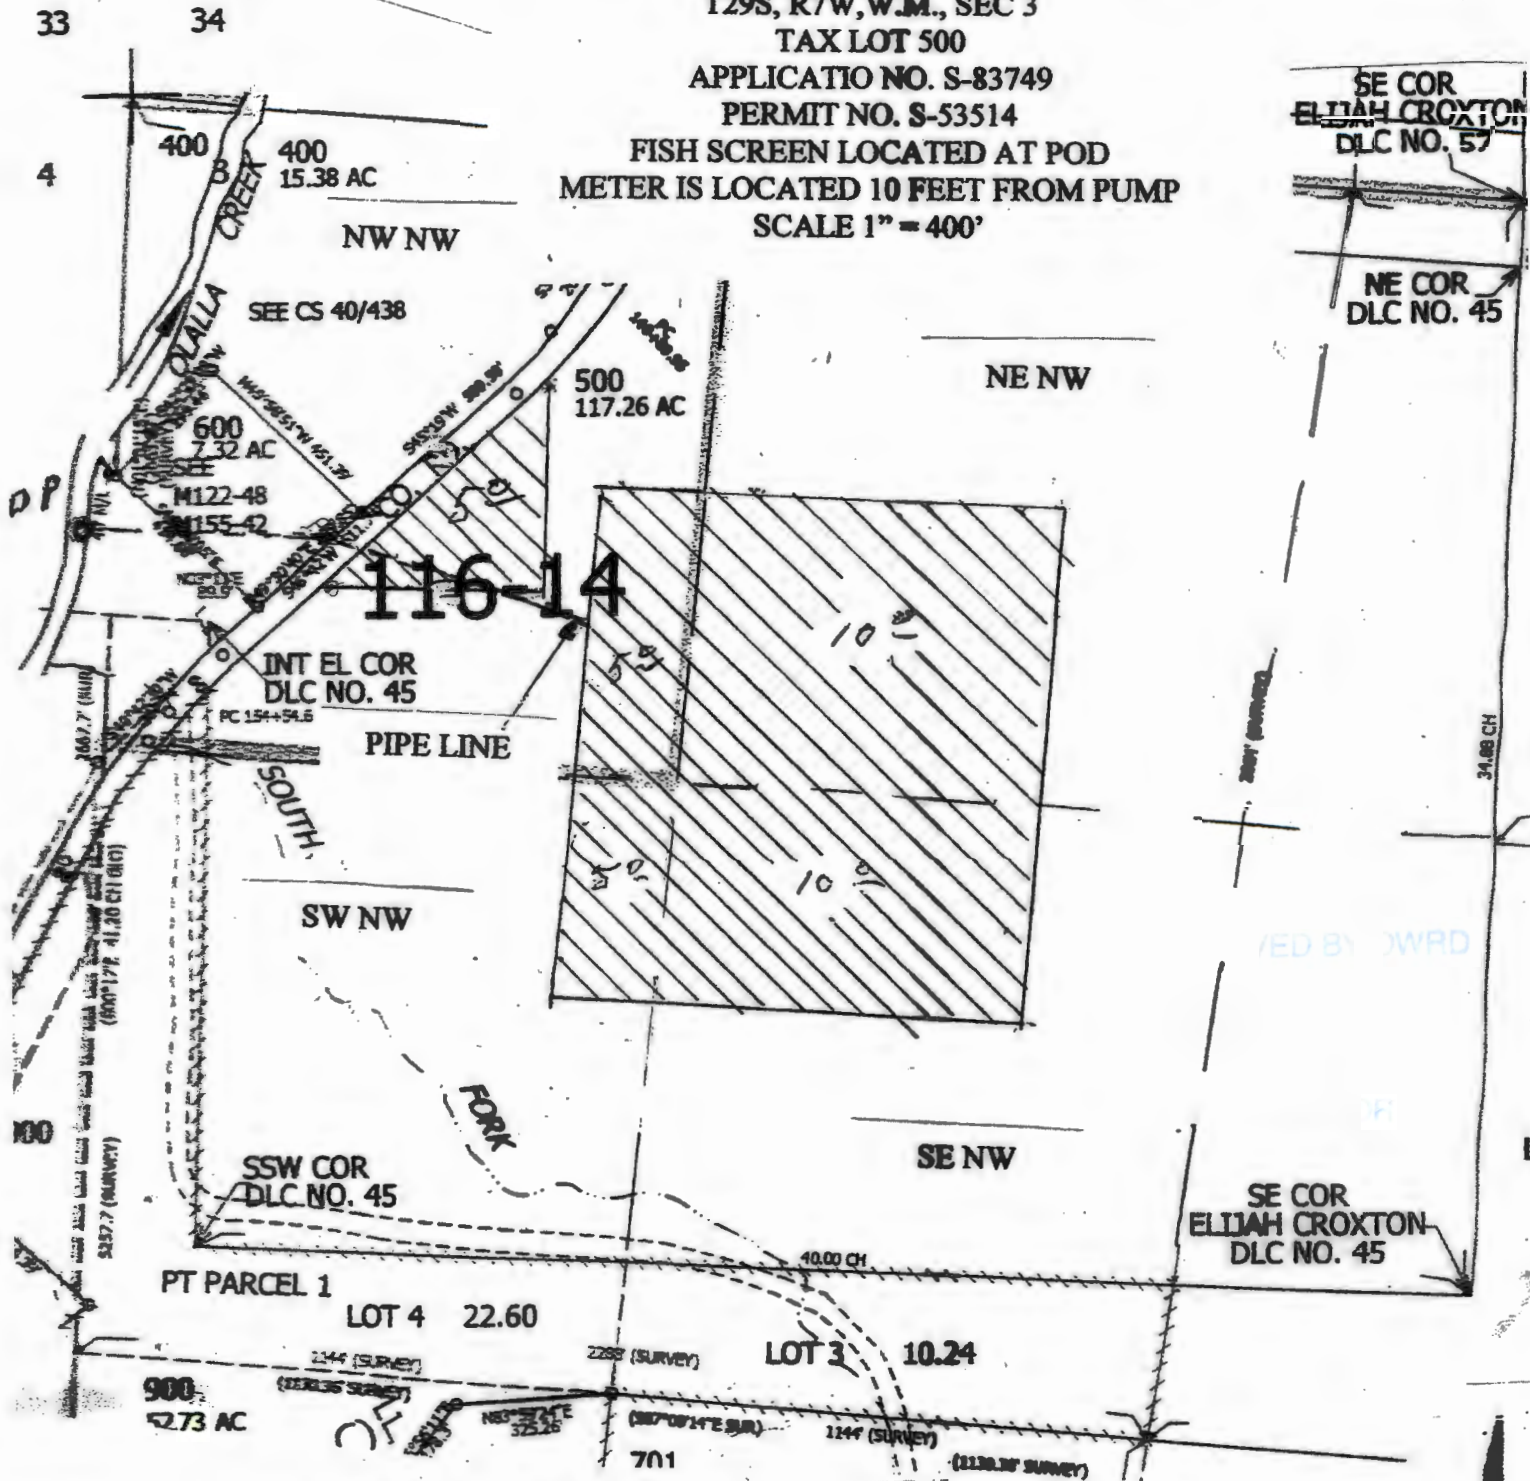

POINT OF DIVERSION LOCATION: NE 1/4 NE 1/4, SECTION 4, T29S, R7W, W.M.;
 900 FEET SOUTH AND 75 FEET WEST FROM THE NW CORNER OF SECTION 3

THE PURPOSE OF THIS MAP IS TO
 IDENTIFY THE LOCATION OF THE
 WATER RIGHT. IT IS NOT INTENDED
 TO PROVIDE INFORMATION RELATIVE
 TO THE LOCATION OF PROPERTY
 OWNERSHIP BOUNDARY LINES.

