

CLAIM OF BENEFICIAL USE MAP

LOCATED IN THE NW 1/4 AND THE SW 1/4
OF SECTION 26, TOWNSHIP 30 SOUTH, RANGE 14 WEST, W.M.
CURRY COUNTY, OREGON
APPLICATION S-87757, PERMIT S-54790

DATE: MARCH 13, 2013

SURVEY METHOD:


THE P.O.D. WAS TIED TO THE NORTHEAST CORNER OF SECTION 26 USING
SURVEY-GRADE GPS EQUIPMENT.

NOTE:

THE POINT OF DIVERSION IS LOCATED 3588 FEET SOUTH AND
4503 FEET WEST OF THE NORTHEAST CORNER OF SECTION 26,
T.30S., R.14W., W.M.



SCALE
1" = 1320 FT.

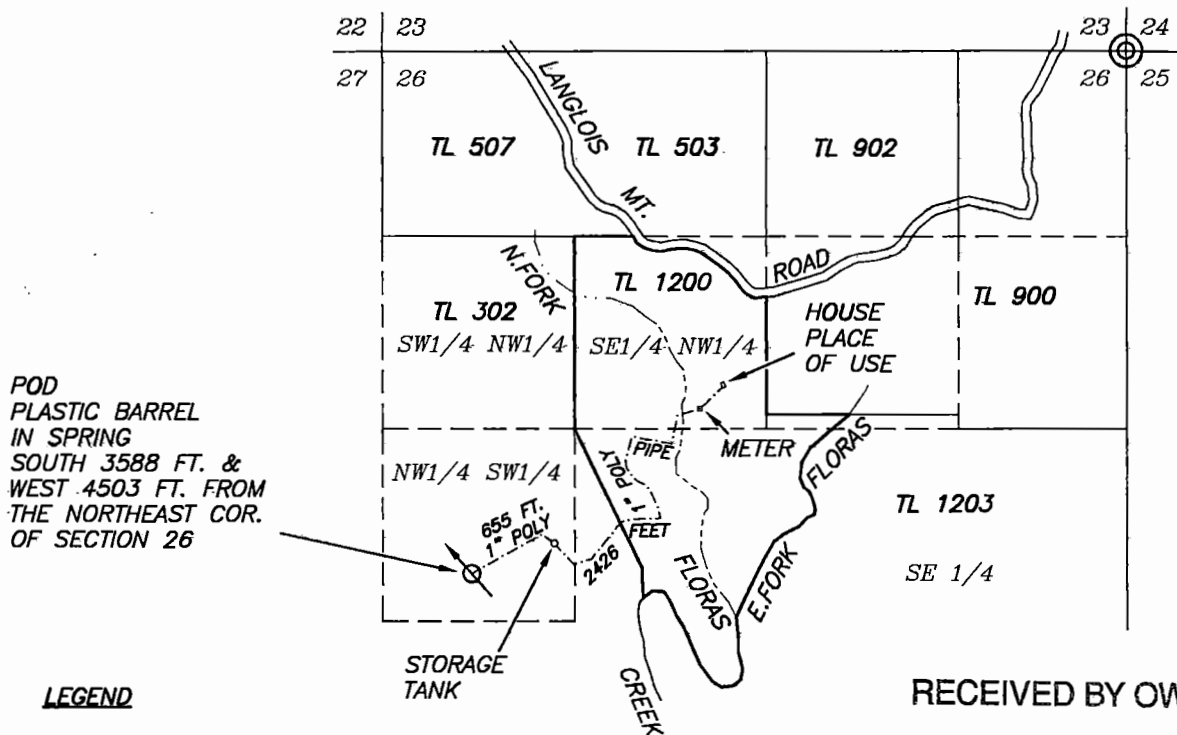

LEGEND

- POINT OF DIVERSION
- POLY PIPE
- FOUND IRON PIPE WITH BRASS CAP

RECEIVED BY OWRD

APR 23 2013

SALEM, OR

EXAMINER'S DISCLAIMER STATEMENT

THE PREPARATION OF THIS MAP WAS FOR THE PURPOSE OF IDENTIFYING
THE LOCATION OF THE WATER RIGHT ONLY AND HAS NO INTENT TO
PROVIDE DIMENSIONS OR LOCATION OF PROPERTY OWNERSHIP LINES.



Stuntzner

Engineering
& Forestry, LLC

705 S. 4TH ST.
P.O. BOX 118
COOS BAY, OREGON 97420

Engineering - Land Surveying - Forestry - Land Planning - Water Rights

PHONE: (541) 267-2872
FAX: (541) 267-0588
www.stuntzner.com

JOB #: 113-040

DATE: April 2013

DRAWN BY: CMW

CHECKED BY: CMW

PREPARED
FOR:

Clatie Smith
97065 Langlois Mt. Rd.
Langlois, OR 97450

FILE NAME: 113-040 Smith COBU.dwg

SHEET 1 OF 1