

Jonathan Todd WR Application

1" = 1320'


Tax Lot: 1400

Jonathan Todd

7/14/2015

↑ North

Township 3 South, Range 1 East, Section 6

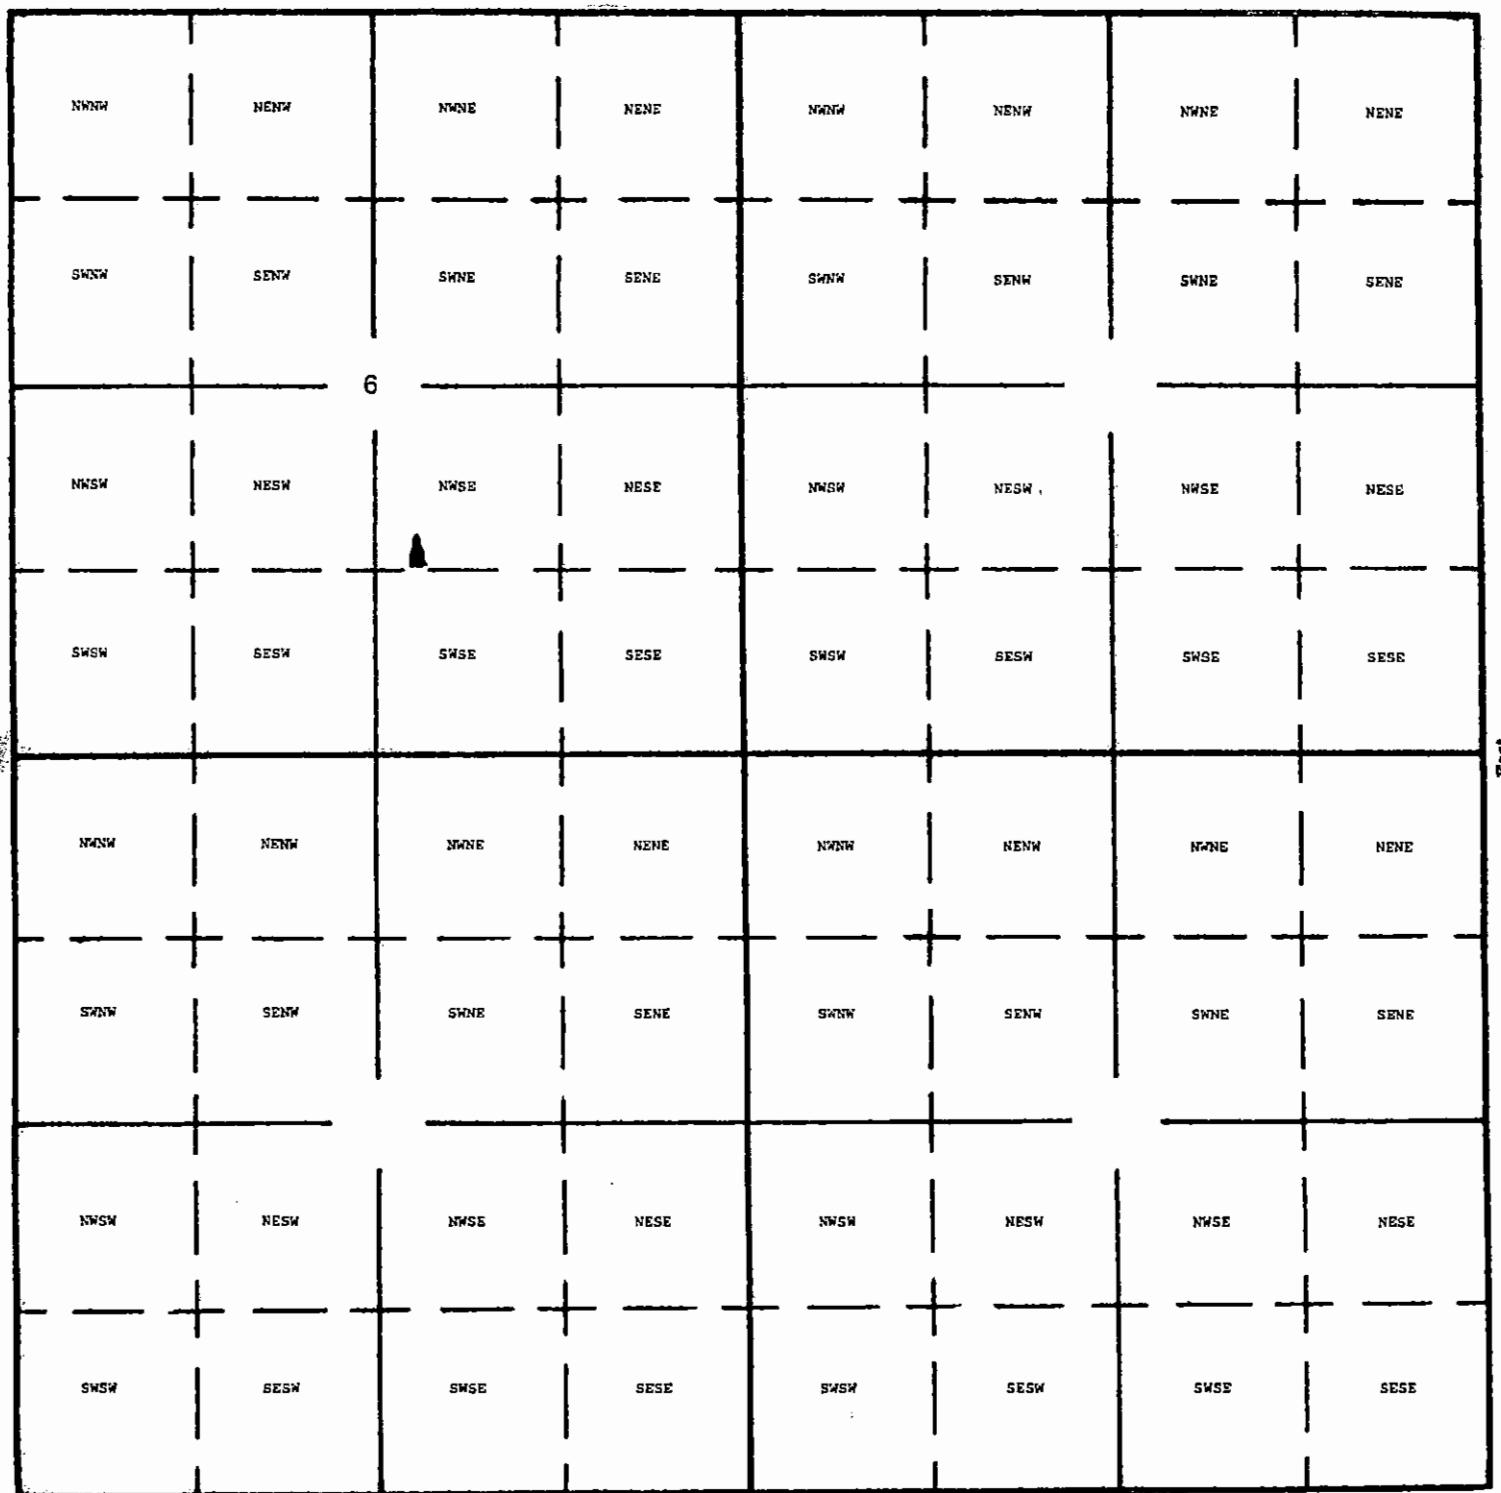

RECEIVED BY OWRD

RECEIVED BY OWRD

JUL 17 2015

MAR 15 2017

SALEM, OR

SALEM, OR

Center of dam: Lat 45.33583 Long -122.73204
1260 Feet South and 330 Feet East from the Center of Section 6