


779

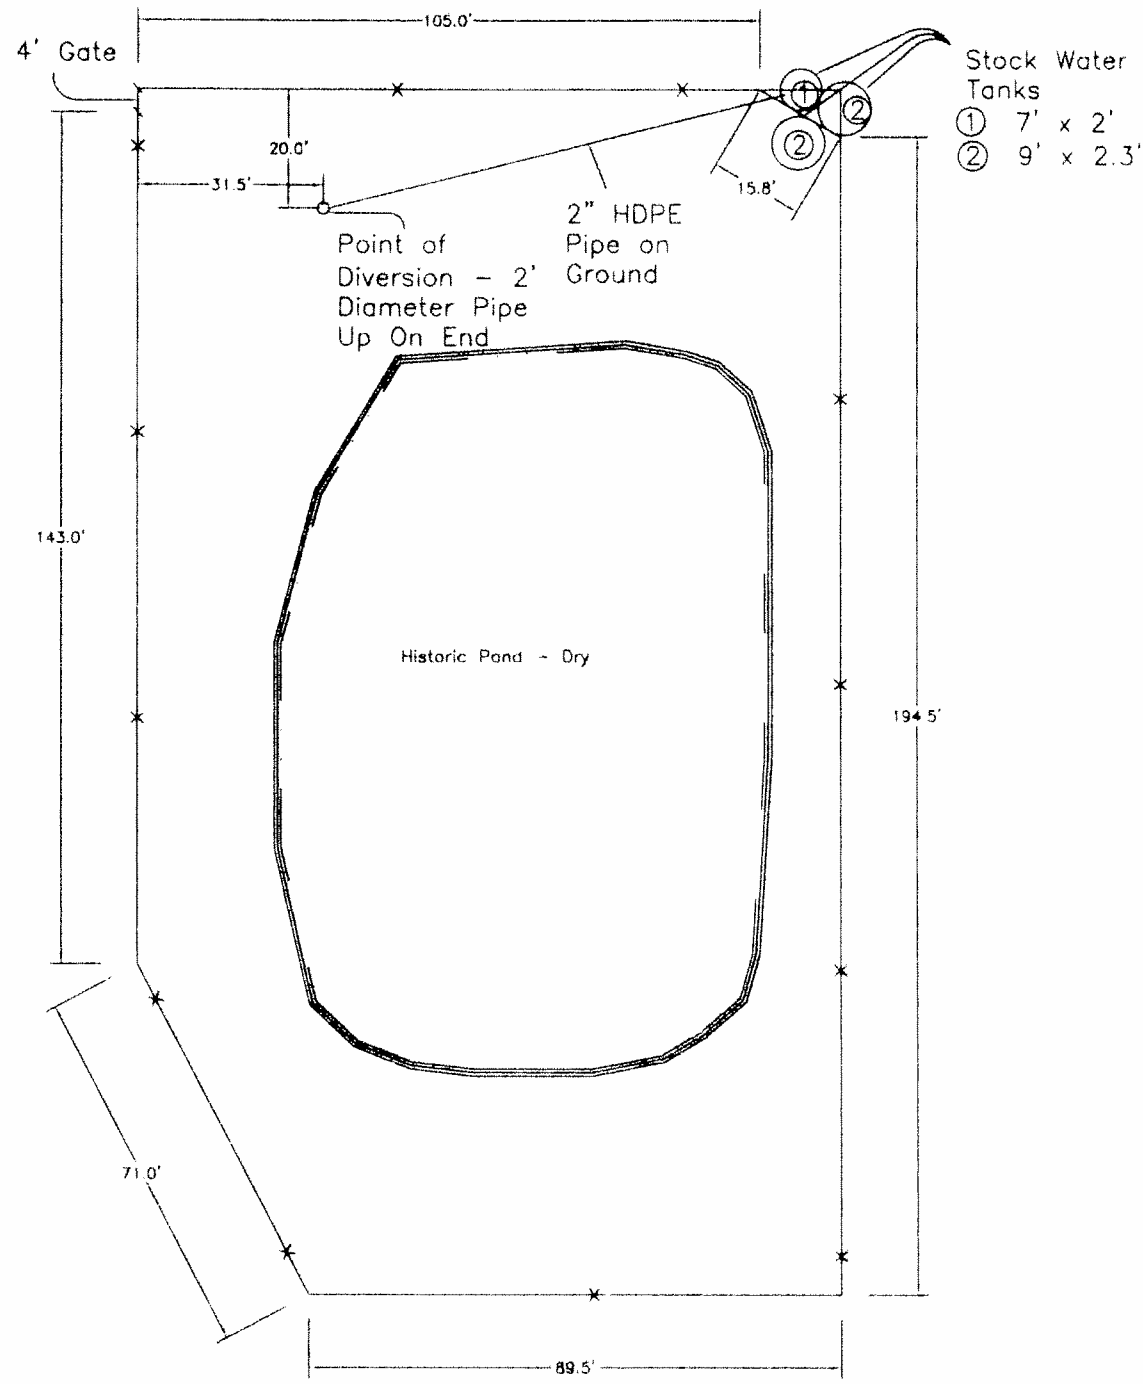

Plan View
Scale 1"=40'


THE PURPOSE OF THIS MAP IS TO IDENTIFY THE LOCATION OF THE WATER RIGHT. IT IS NOT INTENDED TO PROVIDE INFORMATION RELATIVE TO THE LOCATION OF PROPERTY OWNERSHIP.



EXPIRATION DATE: 6/30/2014


COBU MAP # 779

Application Number: 70582
Permit Number: 51865
Tax Lot Number: 500

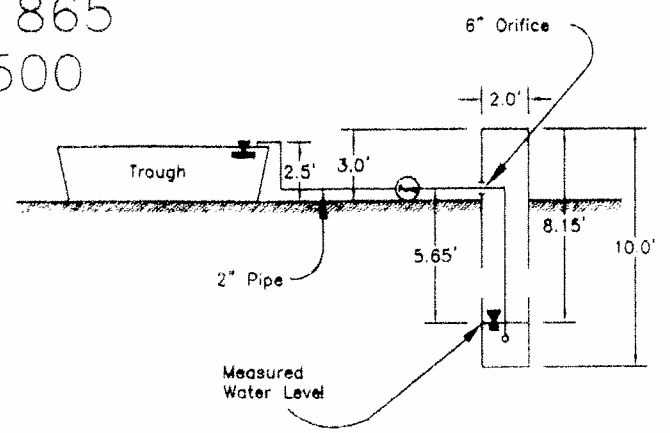

Detail
Scale 1"=10'

Section 5
T.24S., R.30E., W.M.
Harney County, OR

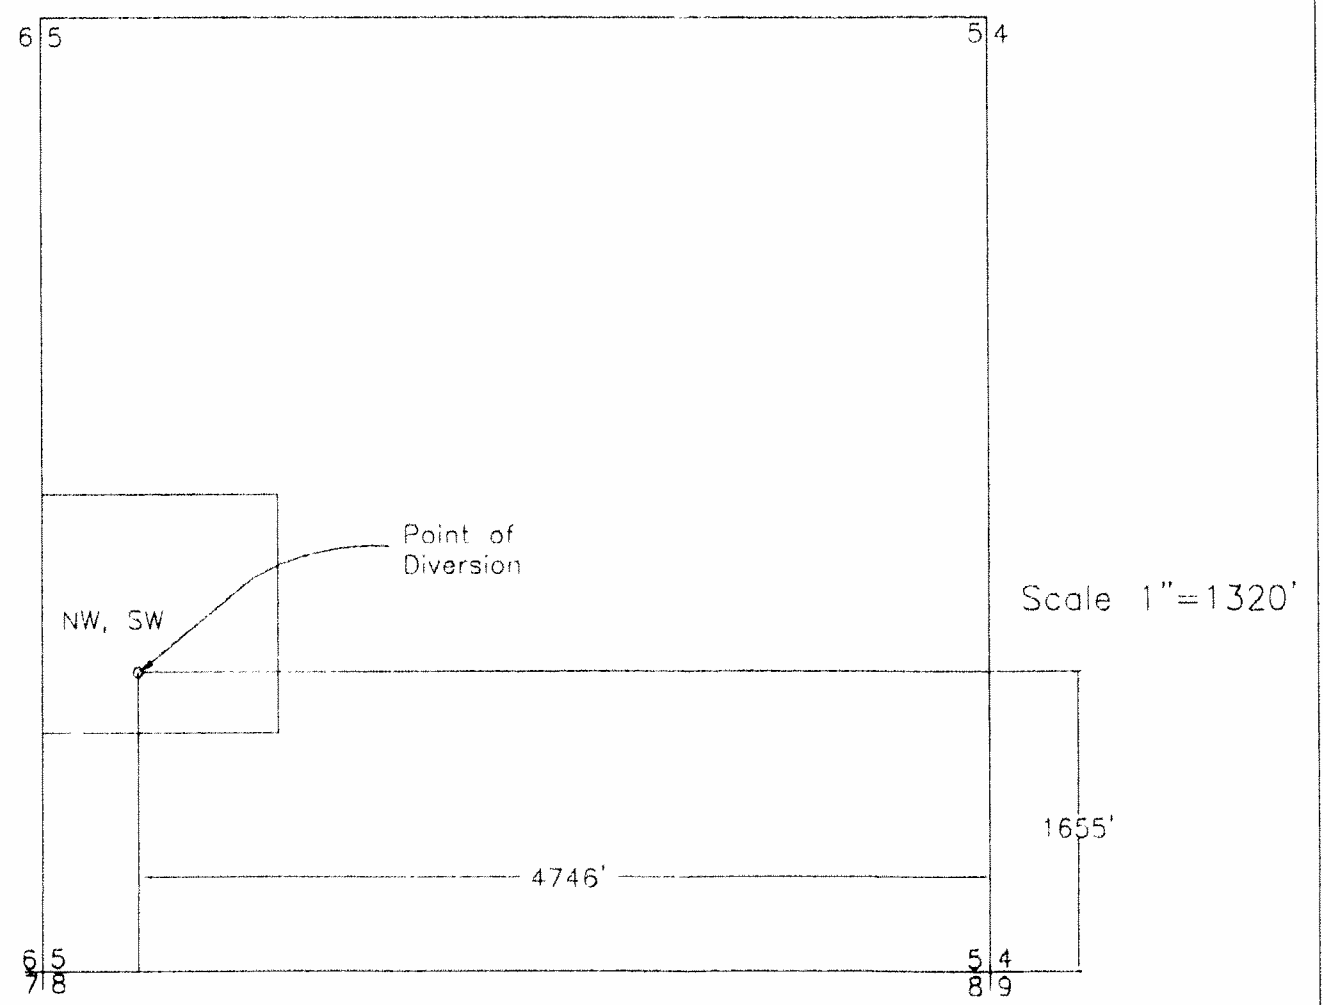

Scale 1"=1320'

Point of Diversion Located 1655 FT North and 4746 FT ~~East~~ West of SE Corner Section 5

WRD has updated this map to reflect the measured distance directional for the pod as being West from the SE corner. MFB/WRD 7/7/17 MBB