

# TRANSFER APPLICATION MAP

FOR: DAVID KENNADAY

BY: NATHAN R. REED, P.E., CWRE

T26S, R3W, W.M. SECTION 3

PERMIT NO. S-44991

CERTIFICATE NO. 58722

SITE VISIT: MAY 7, 2016



RECEIVED BY OWRD

JUL 01 2016

SALEM, OR




## Legend

	POD		58722 Remains
	Pipeline		Transfer From
	Stream		Transfer To
	Flow Arrow		Section
	Houses		Quarter
	Roads		Sixteenth
			Parcels

POD IS LOCATED 2200 FEET NORTH AND 1220 FEET WEST FROM THE NE CORNER OF SECTION 10.

MAP PREPARED FOR:  
DAVID KENNADAY  
PO BOX 69  
GLIDE, OR 97443

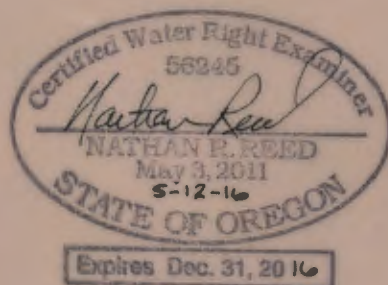


THE PURPOSE OF THIS MAP IS TO IDENTIFY THE LOCATION OF THE WATER RIGHT. IT IS NOT INTENDED TO PROVIDE INFORMATION RELATIVE TO THE LOCATION OF PROPERTY OWNERSHIP BOUNDARY LINES.

MAP PREPARED BY:  
NATHAN R. REED, P.E., CWRE  
1113 SE CASS AV  
ROSEBURG, OR 97470

T 12419

# T. 26 S., R. 3 W., W. M.

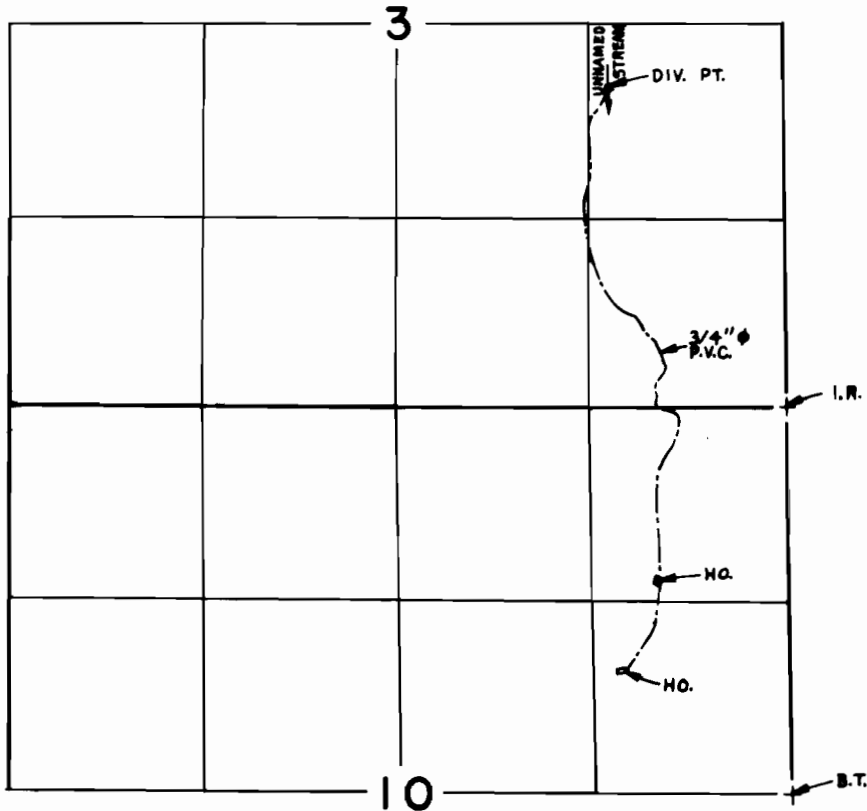

DIV. PT. LOCATED 2,200' N. & 1,228' W. FROM N.E. COR. SEC. 10

SCALE: 4" = 1 mile

## FINAL PROOF SURVEY UNDER

Application No. 59182. Permit No. 44991.....  
IN NAME OF

.....**DAVID KENNADAY**.....

Surveyed **AUG. 14, 1984**, by **L. CASHION**.....