




# T. 40 S., R. 19 E., W.M.

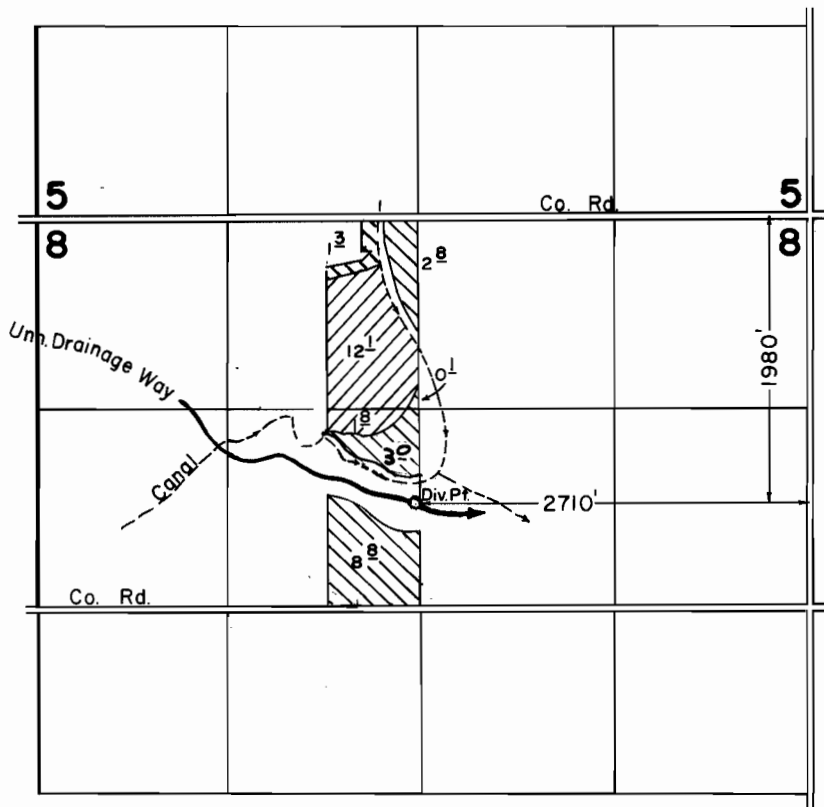

SCALE: 1" = 1320'

## FINAL PROOF SURVEY UNDER

-  PRIMARY
-  SUPPL.

Application No. 61163... Permit No. 45806...  
IN NAME OF

.....LEO H. ALBERTSON.....

Surveyed AUG. 21... 1989, by B.W. BISHOP.....