



**CERTIFIED WATER RIGHT EXAMINER**  
 40411  
*Mark Alan Yeager*  
 MARK ALAN YEAGER  
 JUNE 12, 2008  
 STATE OF OREGON

**Place of Use** (diagonal hatching)  
**Urban Growth Boudary** (thick black line)  
**Township, Range** (thin black line)  
**Sections** (grid lines)

This map was not intended to provide legal dimensions or locations of property ownership lines.

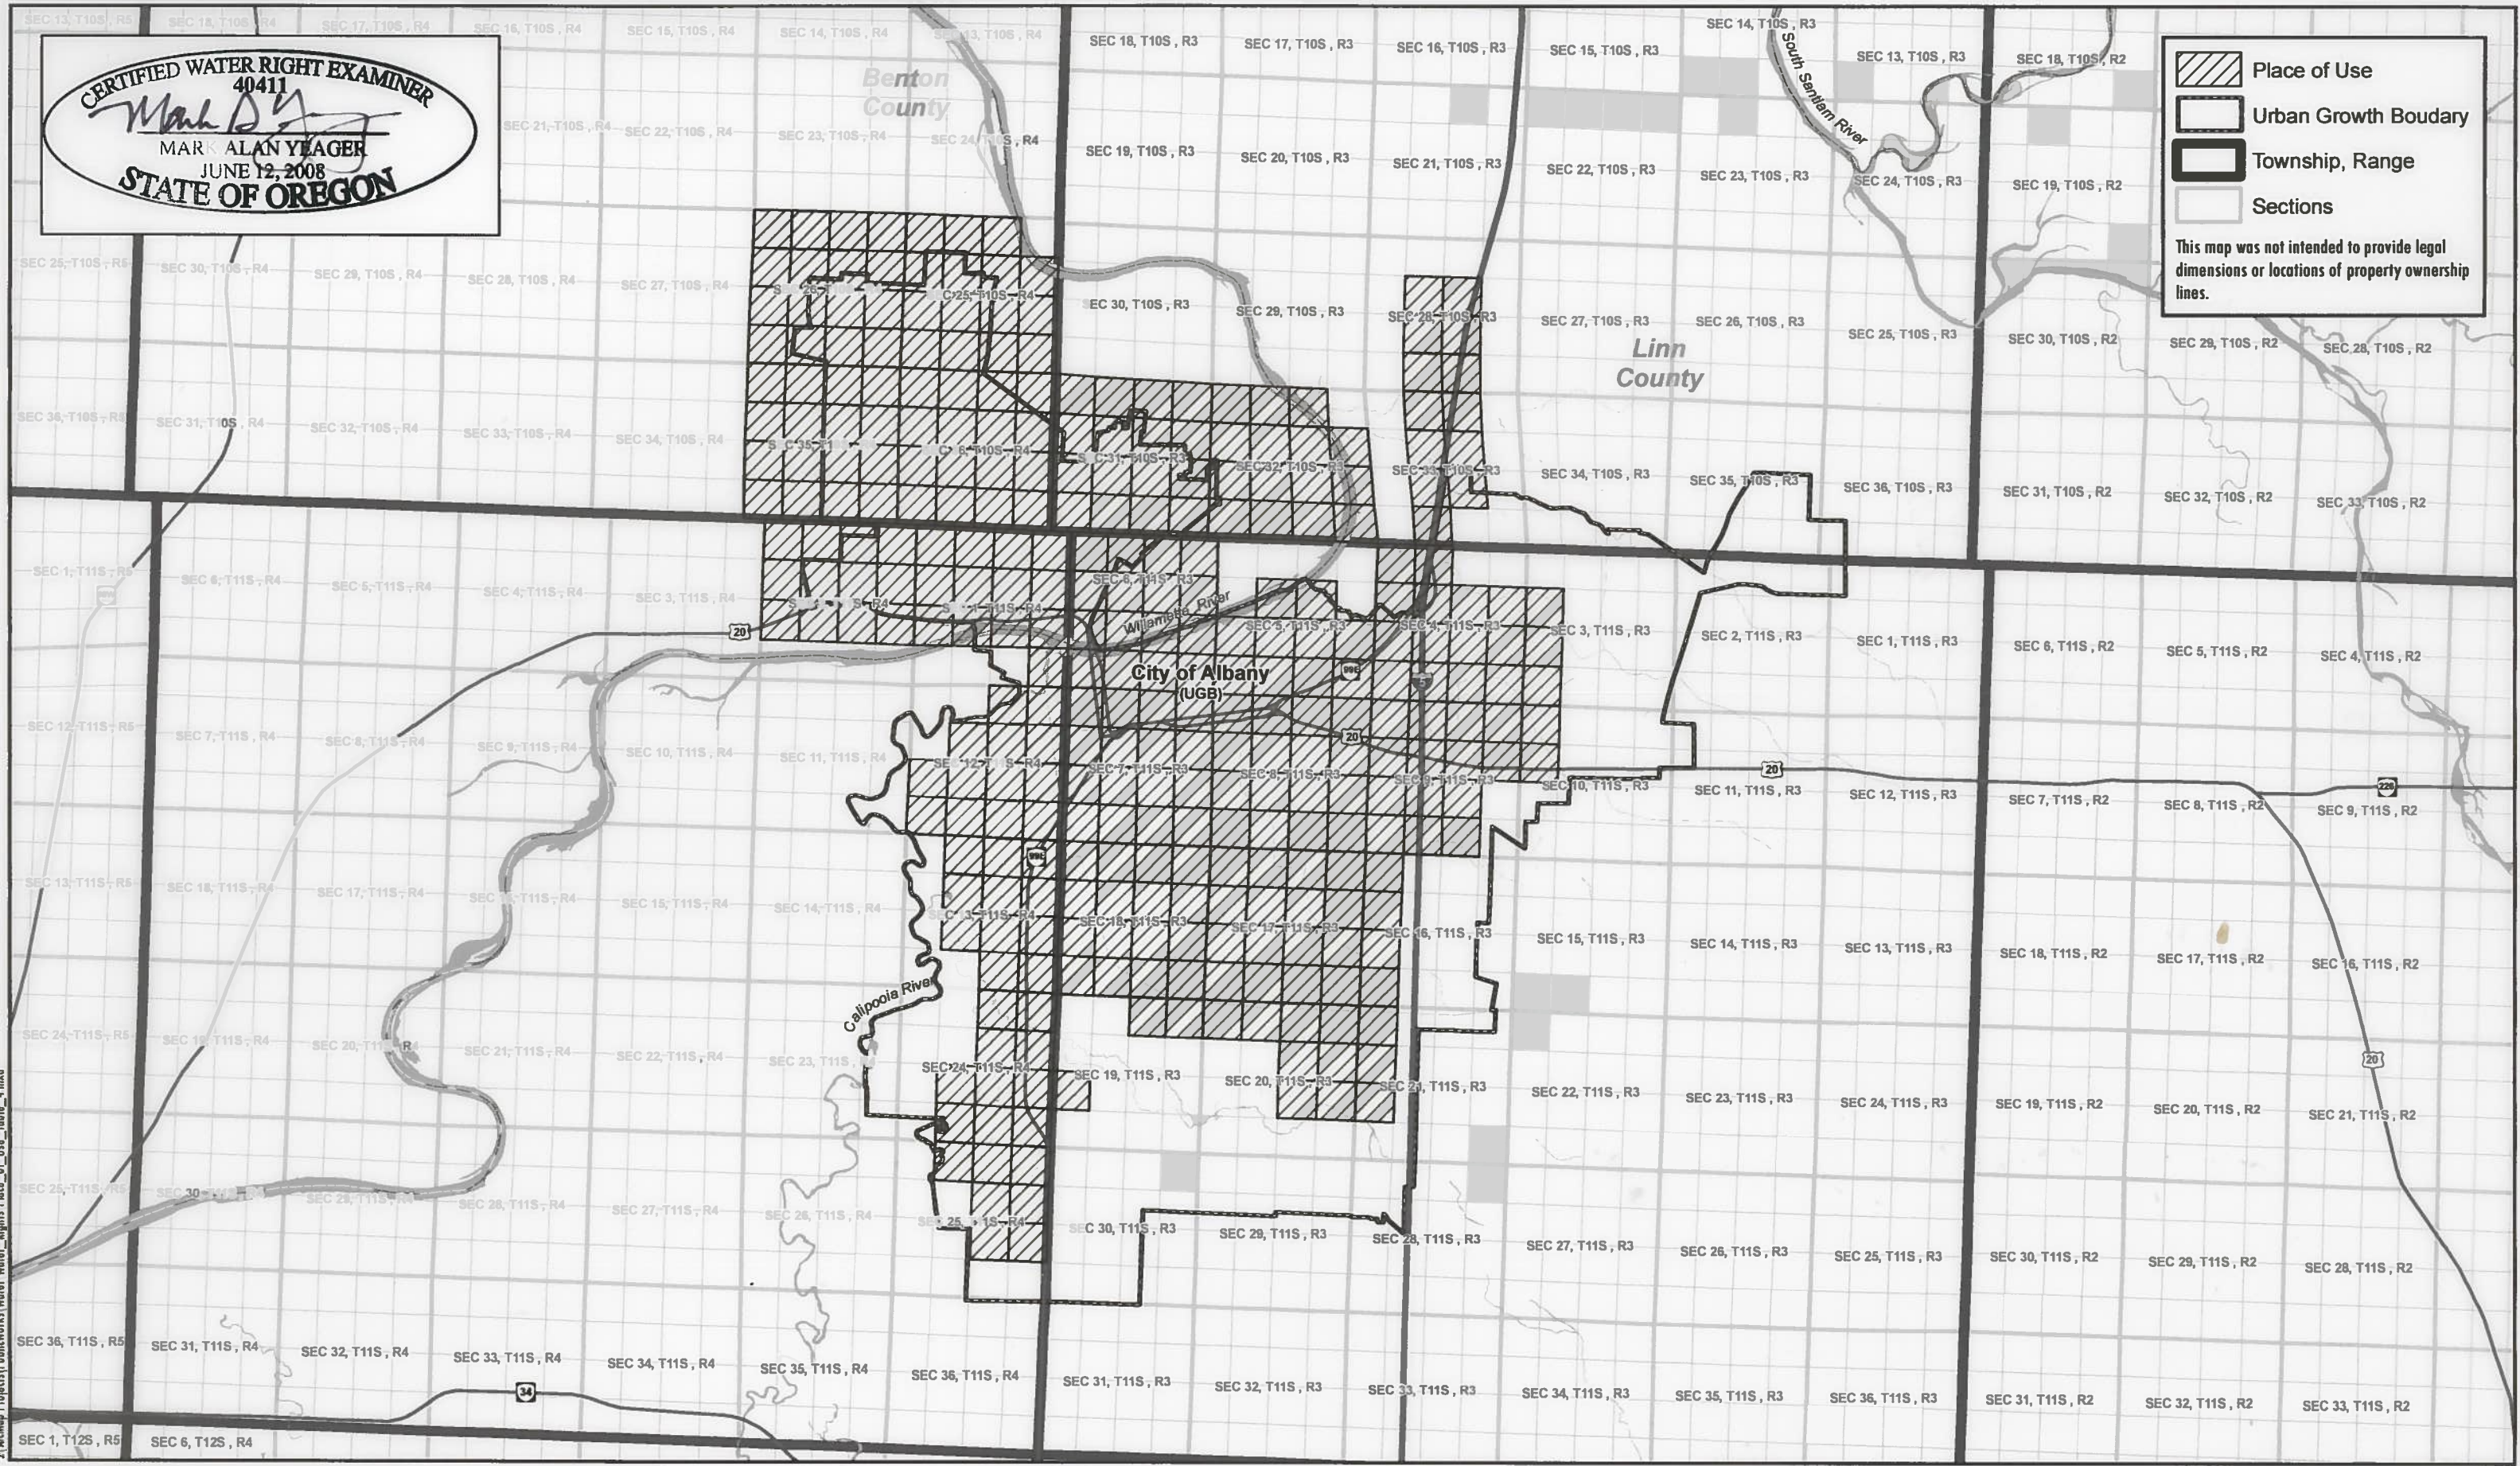

H:\Map\Projects\Public\Works\Water\_Rights\_Place\_of\_Use\_Table\_4.mxd

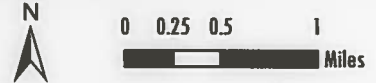

**COBU MAP #1032**

RECEIVED BY OWRD

DEC 08 2016

**Place of Use Map**

Date: 11/14/2016

City of Albany / Claim of Beneficial Use Application #C-58006 / Permit #C-44388