

CLAIM OF BENEFICIAL USE MAP

LOCATED IN THE NE 1/4 OF THE SE 1/4
OF SECTION 21, TOWNSHIP 23 SOUTH, RANGE 12 WEST, W.M.
COOS COUNTY, OREGON
APPLICATION S-81169, PERMIT S-53173


DATE: FEBRUARY 7, 2013

SURVEY METHOD:

THE P.O.D. WAS TIED BY CONVENTIONAL TOTAL STATION
TRAVERSE TO THE EAST 1/4 CORNER OF SECTION 21.

NOTE:

THE POINT OF DIVERSION IS LOCATED 248 FEET
SOUTH AND 324 FEET WEST OF THE EAST 1/4
CORNER OF SECTION 21, T.23S., R.12W., W.M.

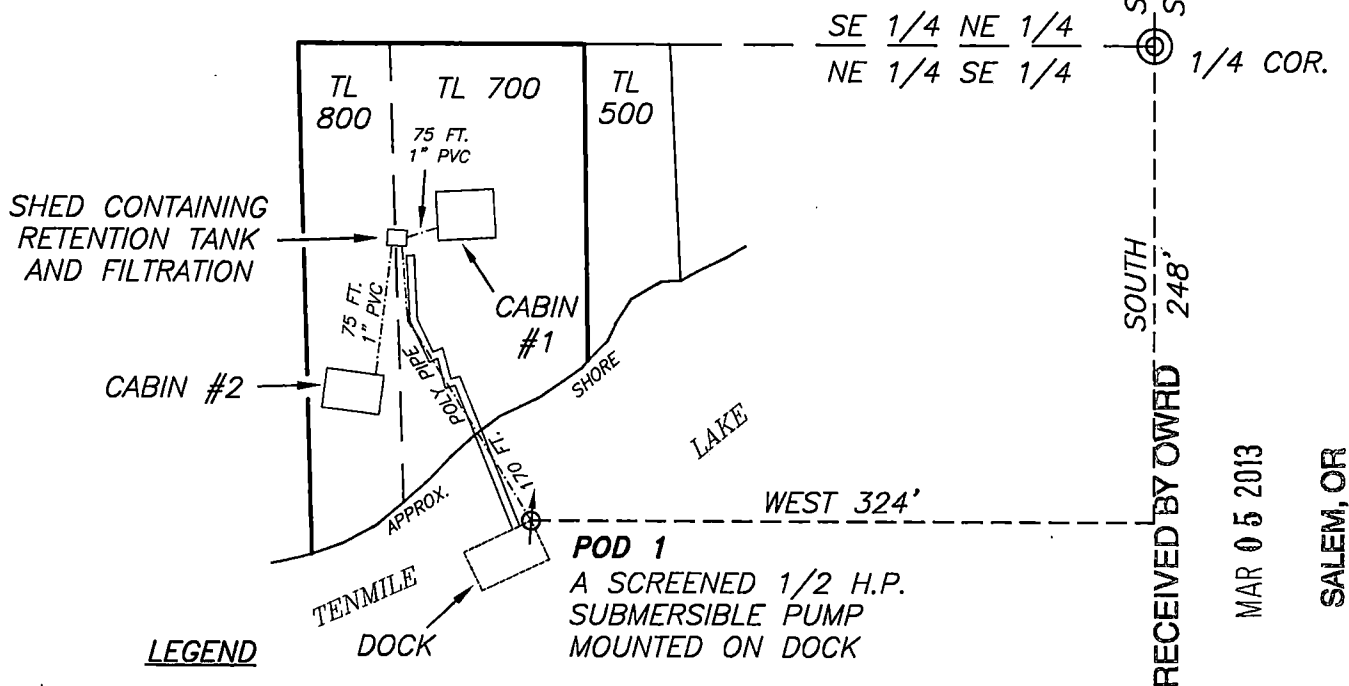

POINT OF DIVERSION

POLY PIPE

FOUND BRASS CAP

EXAMINER'S DISCLAIMER STATEMENT

THE PREPARATION OF THIS MAP WAS FOR THE PURPOSE OF
IDENTIFYING THE LOCATION OF THE WATER RIGHT ONLY AND
HAS NO INTENT TO PROVIDE DIMENSIONS OR LOCATION OF
PROPERTY OWNERSHIP LINES.



705 S. 4TH ST.
P.O. BOX 118
COOS BAY, OREGON 97420

PHONE: (541) 267-2872
FAX: (541) 267-0588
www.stuntzner.com

Engineering - Land Surveying - Forestry - Land Planning - Water Rights

JOB #: 113-022
DATE: February 2013
DRAWN BY: CMW
CHECKED BY: CMW

PREPARED
FOR:

Harold Dean
Coos Bay, OR

FILE NAME: 113-022 Dean COBU.dwg

SHEET 1 OF 1