

**T27S, R34E,
SECTION 7, WM**
HARNEY COUNTY, OREGON

WELL & METER:
1,050' S, 1,850' W OF
NE COR SEC 07




- POU Irrigation
- Township
- Section
- Quarter Quarter
- Tax Lot
- Well
- Mainline
- Gated Pipe

RECEIVED BY OWRD

JUL 13 2017

SALEM, OR

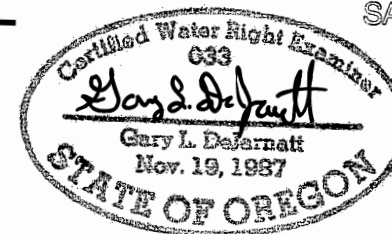

CLAIM OF BENEFICIAL USE
Maher Ranch

AP G-8858

PERMIT G-8244

NOTE: THIS MAP IS NOT INTENDED TO
PROVIDE LEGAL DIMENSIONS OR LOCATIONS
OF PROPERTY OWNERSHIP LINES.

JOB # 16069

JULY 7, 2017

WATER RIGHT SERVICES, LLC

PO BOX 1830, BEND, OR 97709

CCB# 197121 www.oregonwater.us

541-389-2837 JOHNSHORT@USA.COM