

Claim of Beneficial Use Map for Metolius Meadows

T-12290



ESTES SURVEYS, LLC
 PO Box 17549 60382 Arnold Rd
 Salem, OR 97305-7549 Bend, OR 97702
 (503) 585-7593 (541) 382-7391

lots identified by No.

Section 16, T.13S., R. 9E., W.M.

This map is for the purpose of locating a water right only and has no intent to provide legal dimensions or the location of property lines.

Scale
1" = 400'

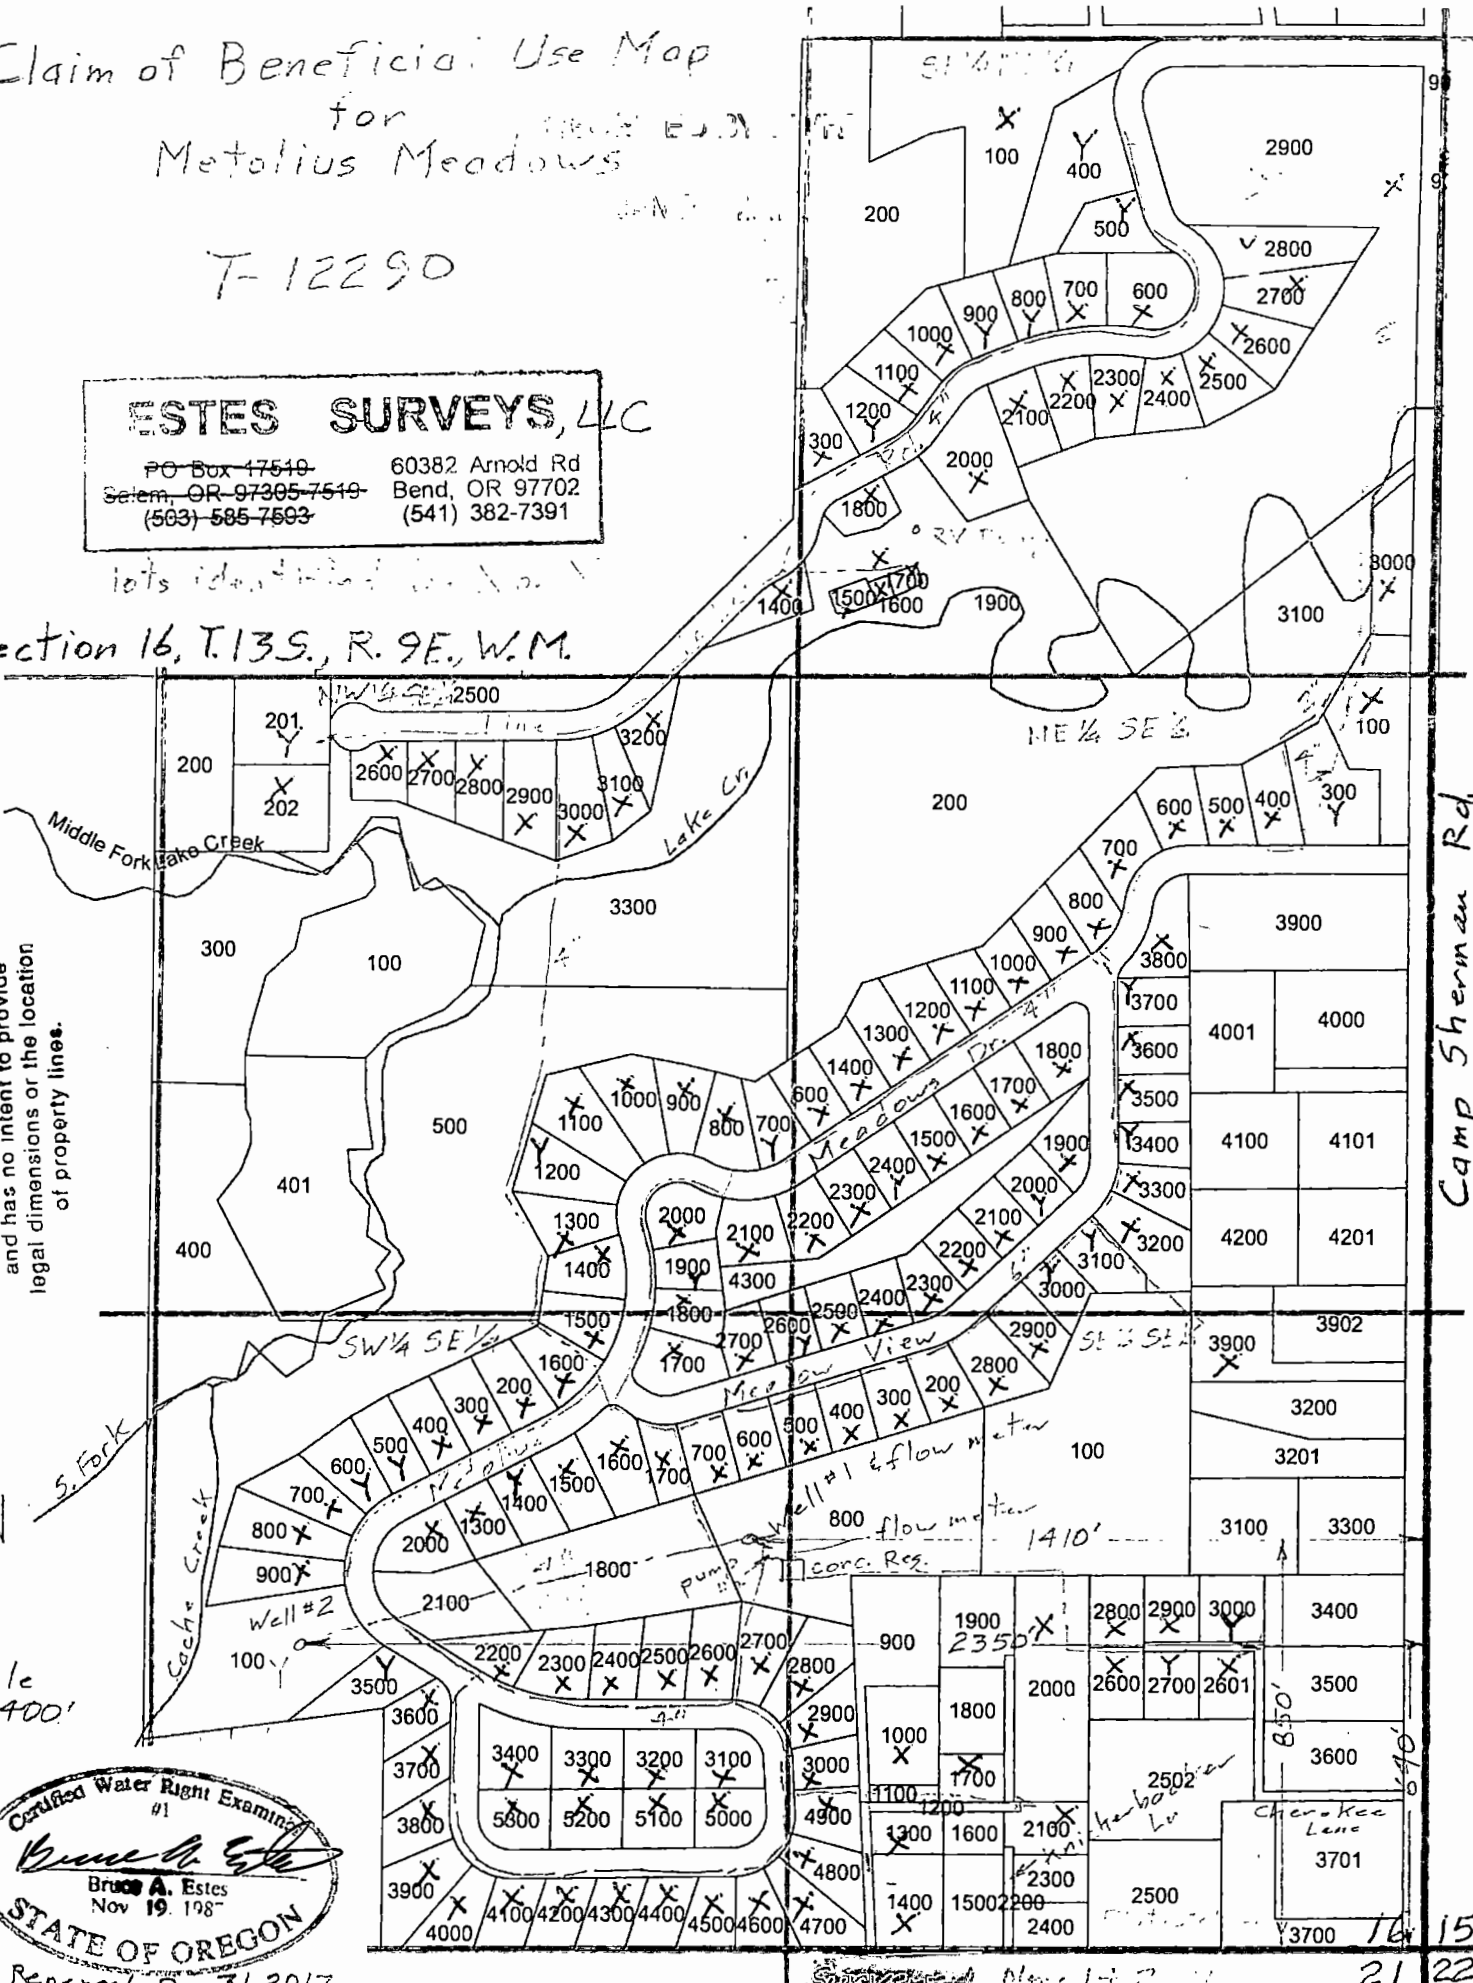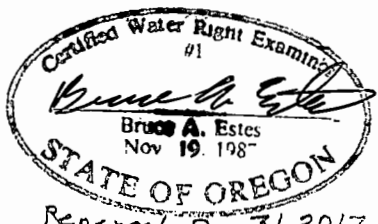

Surveyed Nov 14, 2014 21 22