


CLAIM OF BENEFICIAL USE MAP
FOR YURY AND YEKATERINA ZADEREY
LOCATED IN THE SW1/4 OF THE NW1/4 OF SECTION 10,
TOWNSHIP 23 SOUTH, RANGE 12 WEST, W.M.,
COOS COUNTY, OREGON

APPLICATION #S-81523
PERMIT #53247

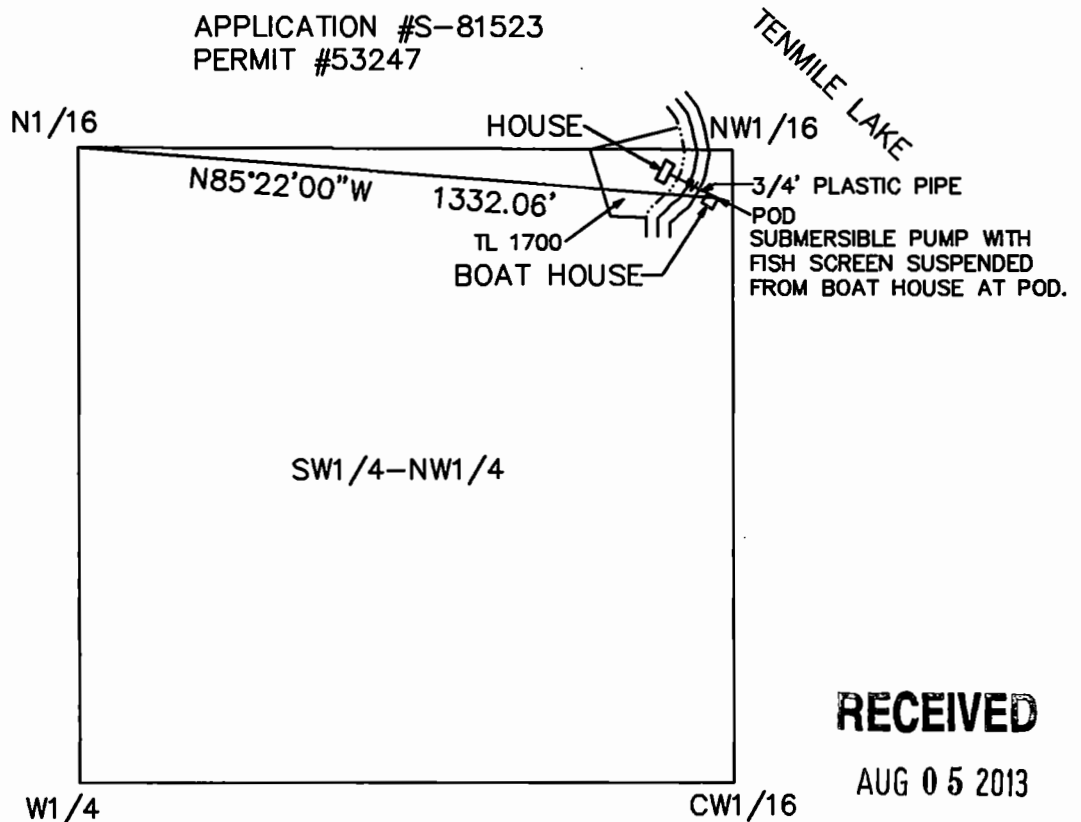

RECEIVED

AUG 05 2013


WATER RESOURCES DEPT
SALEM, OREGON

LEGEND:

POD POINT OF DIVERSION

TL TAX LOT

—w— WATER PIPE LINE

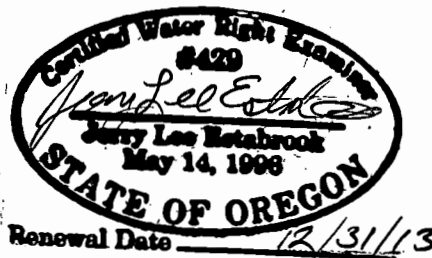

EXAMINERS DISCLAIMER STATEMENT:

THE PREPARATION OF THIS MAP WAS FOR THE PURPOSE OF
IDENTIFYING THE LOCATION OF WATER RIGHT ONLY AND HAS
NO INTENT TO PROVIDE DIMENSIONS OR LOCATION OF
PROPERTY OWNERSHIP LINES.

SCALE 1" = 400'