APPROX MAP SCALE 1" = 400 FEET

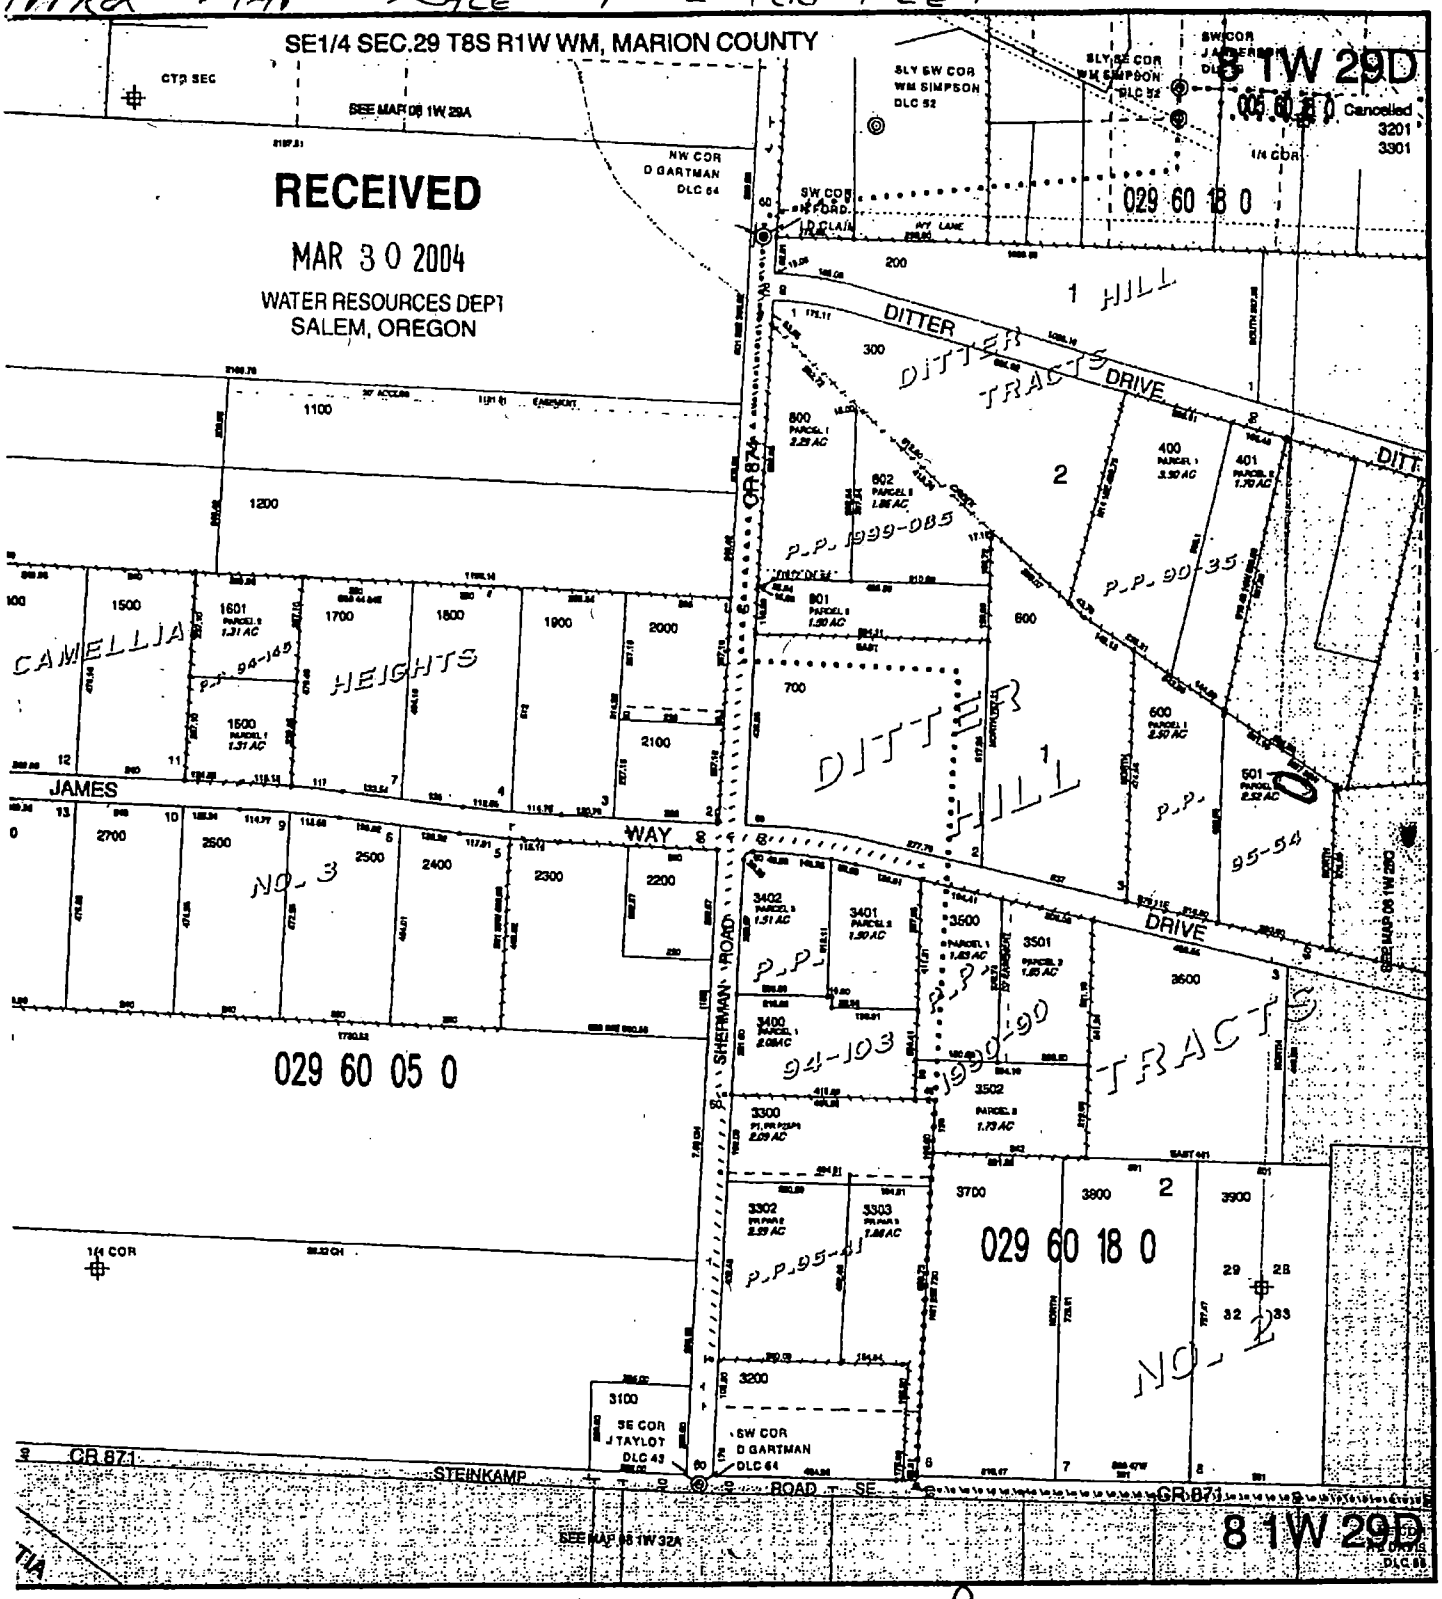

RESERVOIR LOCATED FROM COMMON SECTIONS 28, 29, 32, 33.

BEING WITHIN 1140 ft. NORTH
SW/4 SW/4 40 ft EAST
SECTION 28

RECEIVED BY OWRD

APR 12 2017

SALEM, OR