



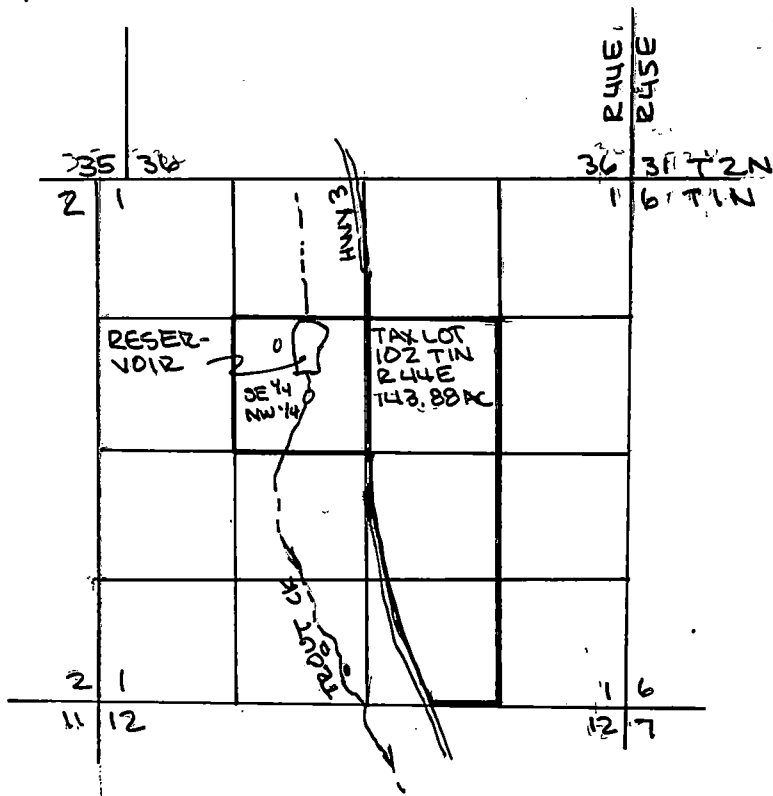

CENTER OF DAM IS 2020' S
AND 3350' W OF THE NE
CORNER SEC 1 T1N, R44E,
IN THE SE 1/4, NW 1/4

MAX DEPTH TO OVERFLOW = 4.6'
MAX DEPTH TO SPILLWAY = 5.1'
DAM TOP TO SPILLWAY = 3.1'
STORAGE VOLUME = 8.7 ACFT

MAP IS BASED ON USGS
QUAD MAP HICKS SPRINGS,
CS 1992-025, AND
AERIAL PHOTO

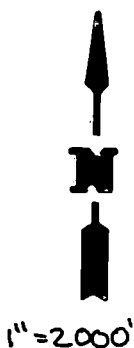


RECEIVED BY OWRD

MAR 17 2017

SALEM, OR

THIS MAP IS PREPARED FOR WATER
RIGHT PURPOSES ONLY AND SHOULD
NOT BE USED FOR PROPERTY LOCATION
PURPOSES

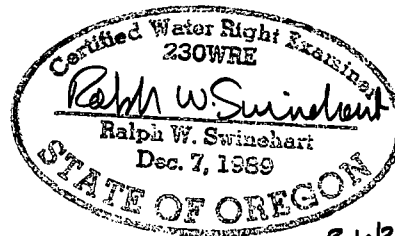

26/30/18

A MULTI PURPOSE STORAGE RESERVOIR
IN SE 1/4, NW 1/4, SEC 1, T1N, R44E
WALLOWA COUNTY, OREGON
R-14152

FINAL PROOF SURVEY MAP
FOR: HELEN ELLIS
PO BOX 105
ENTERPRISE, OREGON 97828
PREPARED BY:
WALLOWA MTN ENGINEERING, SEPT 2016