


T25&26S, R6&7W, WM

DOUGLAS COUNTY

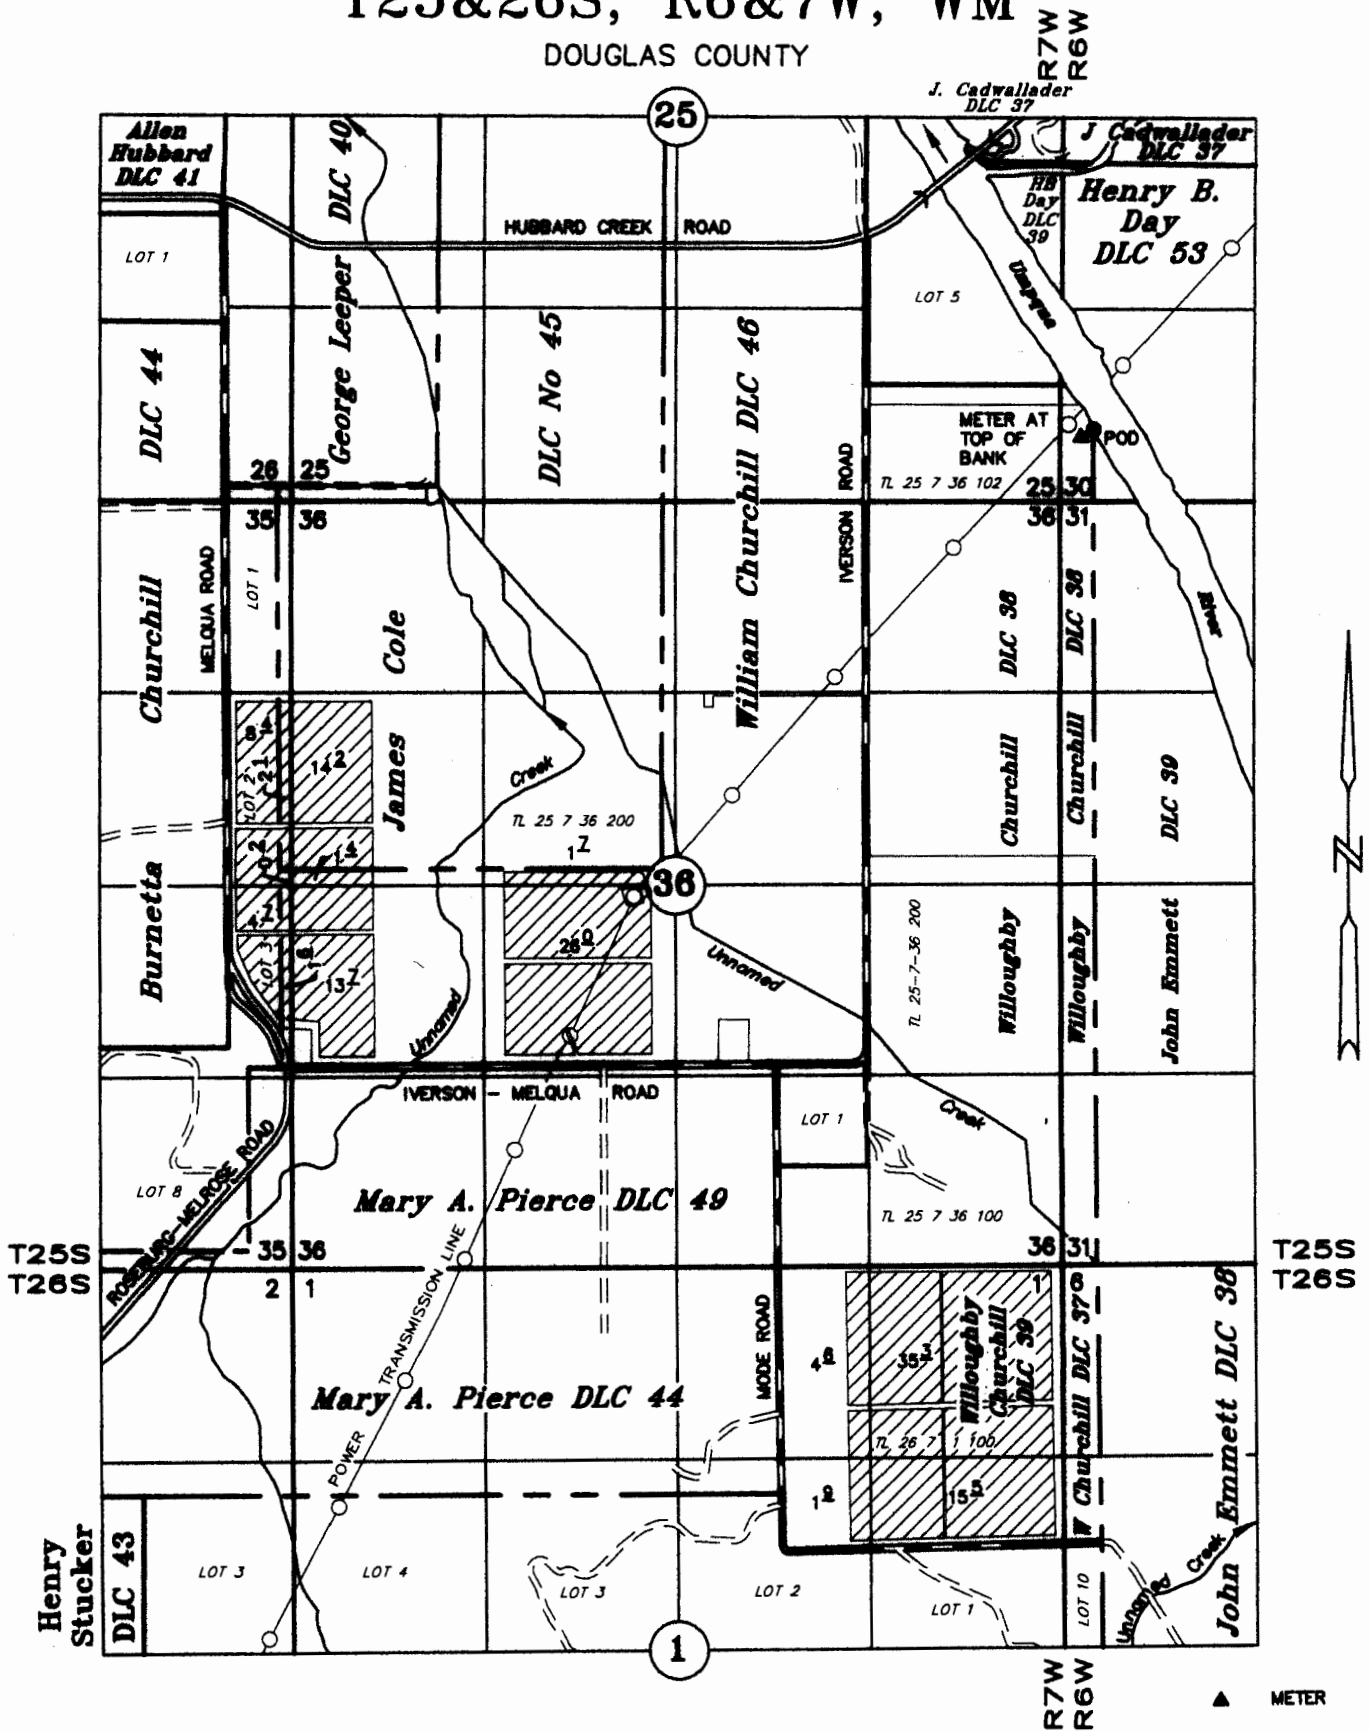

POD: 1560' E & 305' S OF THE NW COR OF THE WILLOUGHBY CHURCHILL DLC No 38
 METER: 1450' E & 320' S OF THE NW COR OF THE WILLOUGHBY CHURCHILL DLC No 38

TAX LOTS:
 25 7 36 100
 25 7 36 102
 25 7 36 200
 26 7 1 100

CLAIM OF BENEFICIAL USE

UNDER

Application No. 30483 Permit No. 24008 Transfer No. T-10964

RECEIVED

IN THE NAME OF

EGM, LLC

SEPTEMBER 17, 2012
 DECEMBER 10, 2013

SCALE: 1" = 1320'




WATER RIGHTS DIVISION DEPT
 SALLA, OREGON

NOTE: This map is not intended to provide legal dimensions or locations of property ownership lines.

RENEWAL DATE: 12-31-2017

T25&26S, R6&7W, WM

DOUGLAS COUNTY

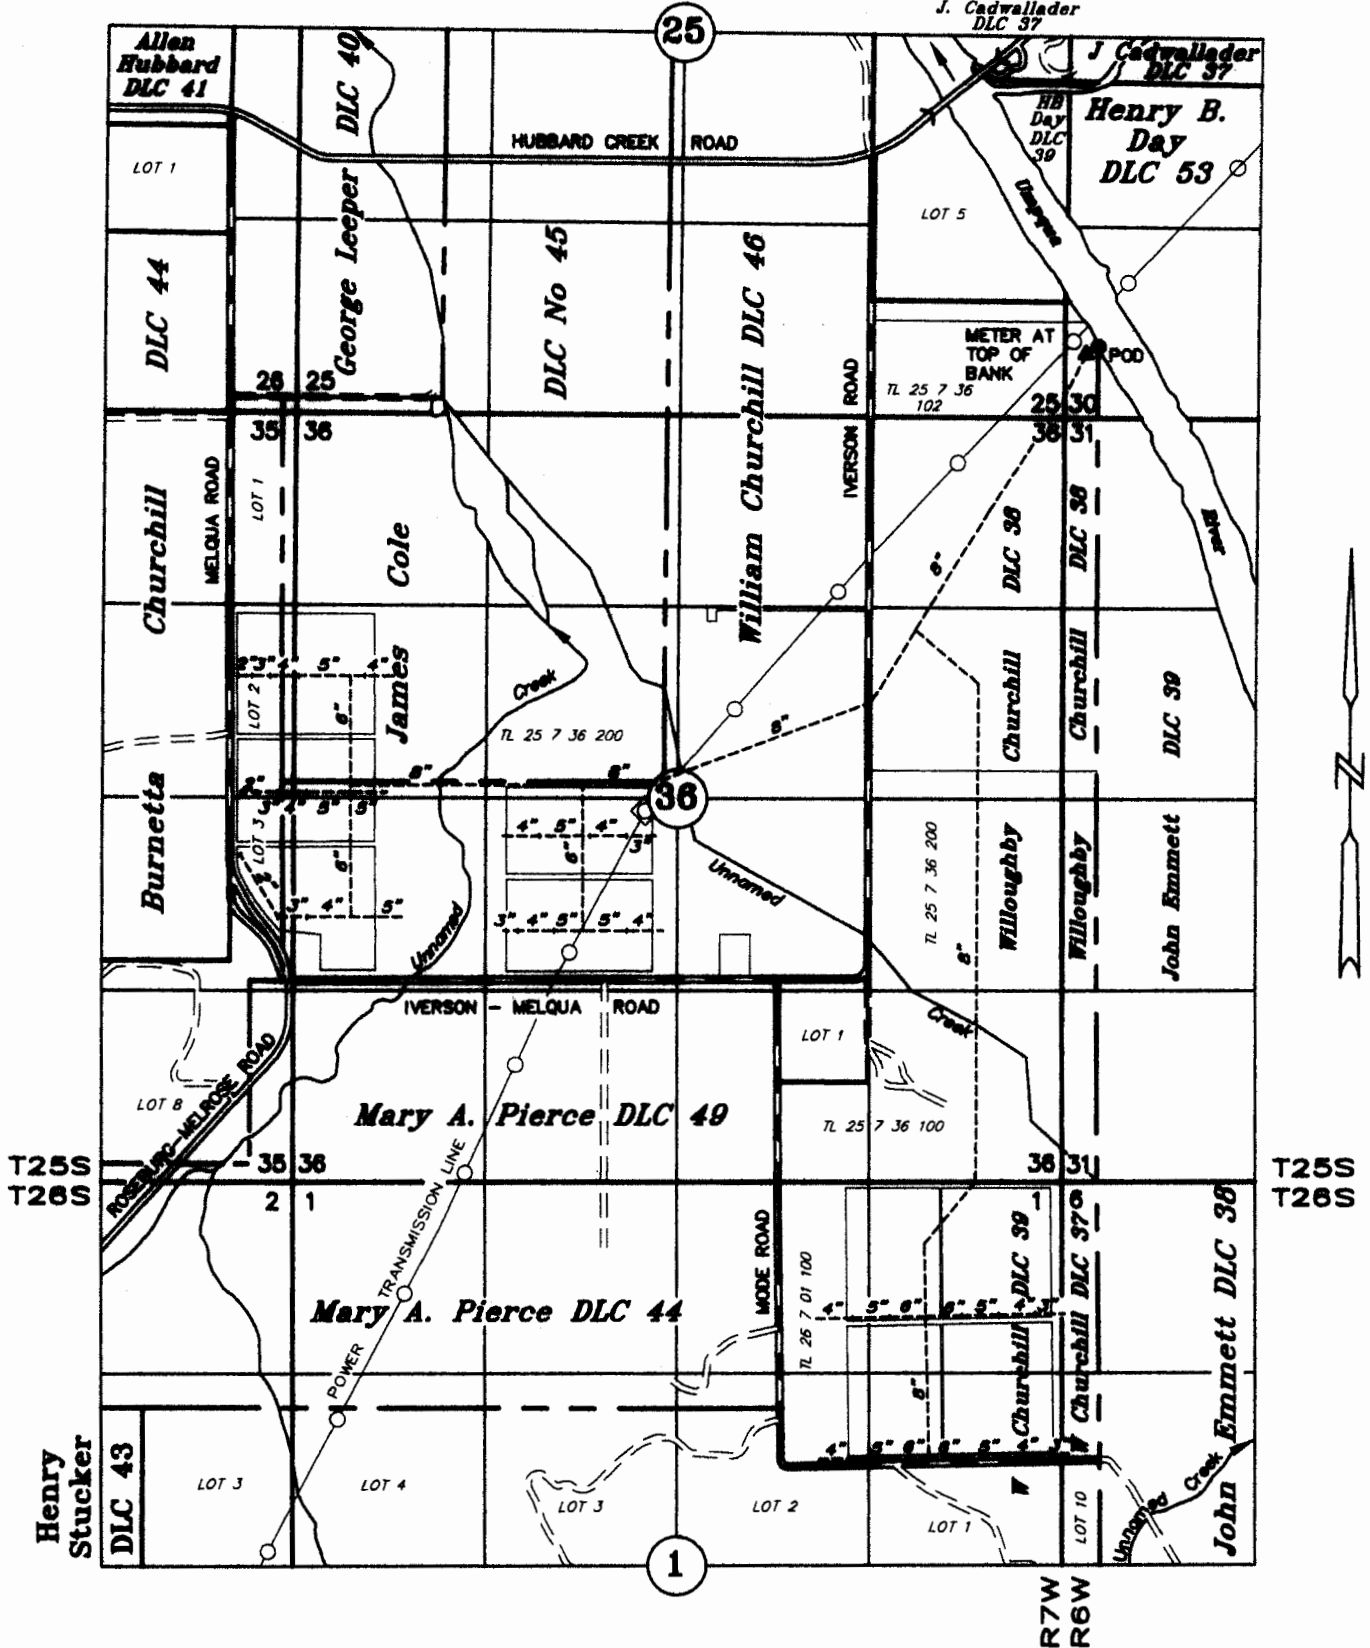

POD: 1560' E & 305' S OF THE NW COR OF THE WILLOUGHBY CHURCHILL DLC No 38
 METER: 1450' E & 320' S OF THE NW COR OF THE WILLOUGHBY CHURCHILL DLC No 38

- TAX LOTS:
 25 7 36 100
 25 7 36 102
 25 7 36 200
 26 7 1 100

CLAIM OF BENEFICIAL USE

----- BURIED PIPELINE
 ▲ METER

UNDER


Application No. 30483 Permit No. 24008 Transfer No. T-10964

IN THE NAME OF

EGM, LLC

SEPTEMBER 17, 2012
 DECEMBER 10, 2013

SCALE: 1" = 1320'

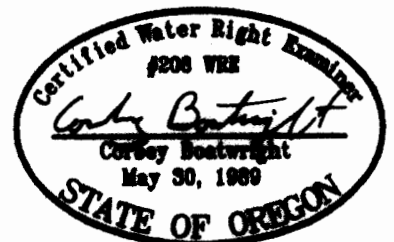

NOTE: This map is not intended to provide legal dimensions or locations of property ownership lines.

RENEWAL DATE: 12-31-2017