


T.4S. R.2E. Section 1, W.M.



RENEWS JUNE 30, 2015

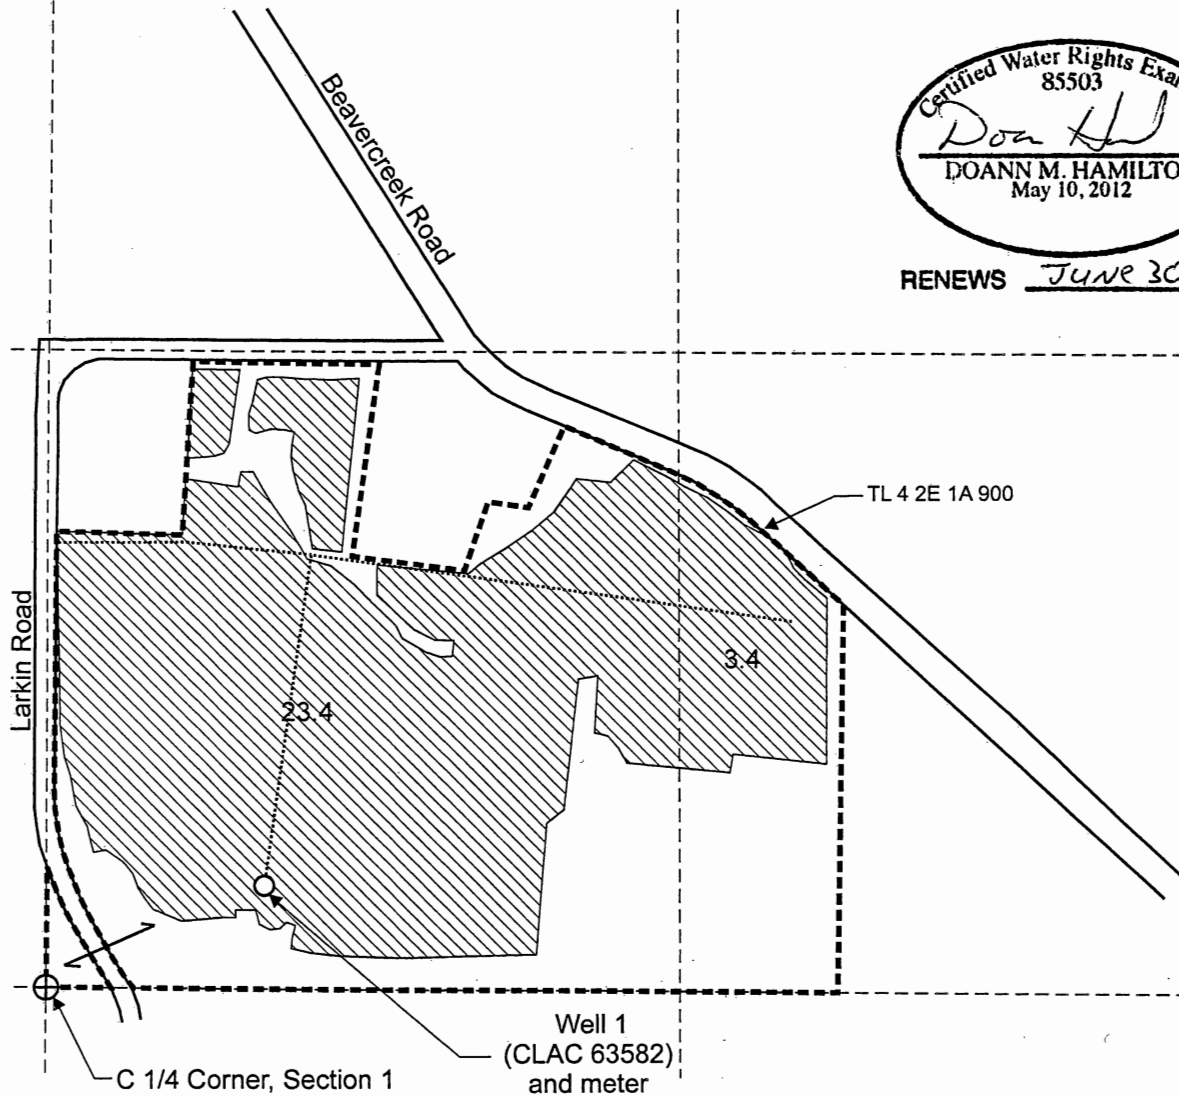

Well 1 (CLAC 63582) is located 200 feet north and 450 feet east from the C 1/4 corner of Section 1.

Area (26.8 Acres) irrigated under Application G-16889, Permit G-16451.

Tax lot boundary

Mainlines

RECEIVED

JAN 29 2014


WATER RESOURCES DEPT
SALEM, OREGON

RECEIVED

DEC 27 2013

WATER RESOURCES DEPT
SALEM, OREGON

Scale: 1" = 400'

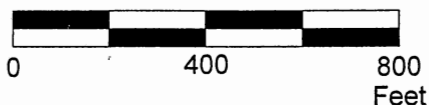

This map was prepared for the purpose of identifying the location of a water right only and is not intended to provide legal dimensions or location of property ownership lines.



Pacific Hydro-Geology Inc.

Claim of Beneficial Use Map
Application G-16889, Permit G-16451

Michael W. And Laurie C. Durkin
T.4S. R.2E. Section 1, W.M.

12/2013