


Section 10, T.38S., R.7W., W.M.

T-11438

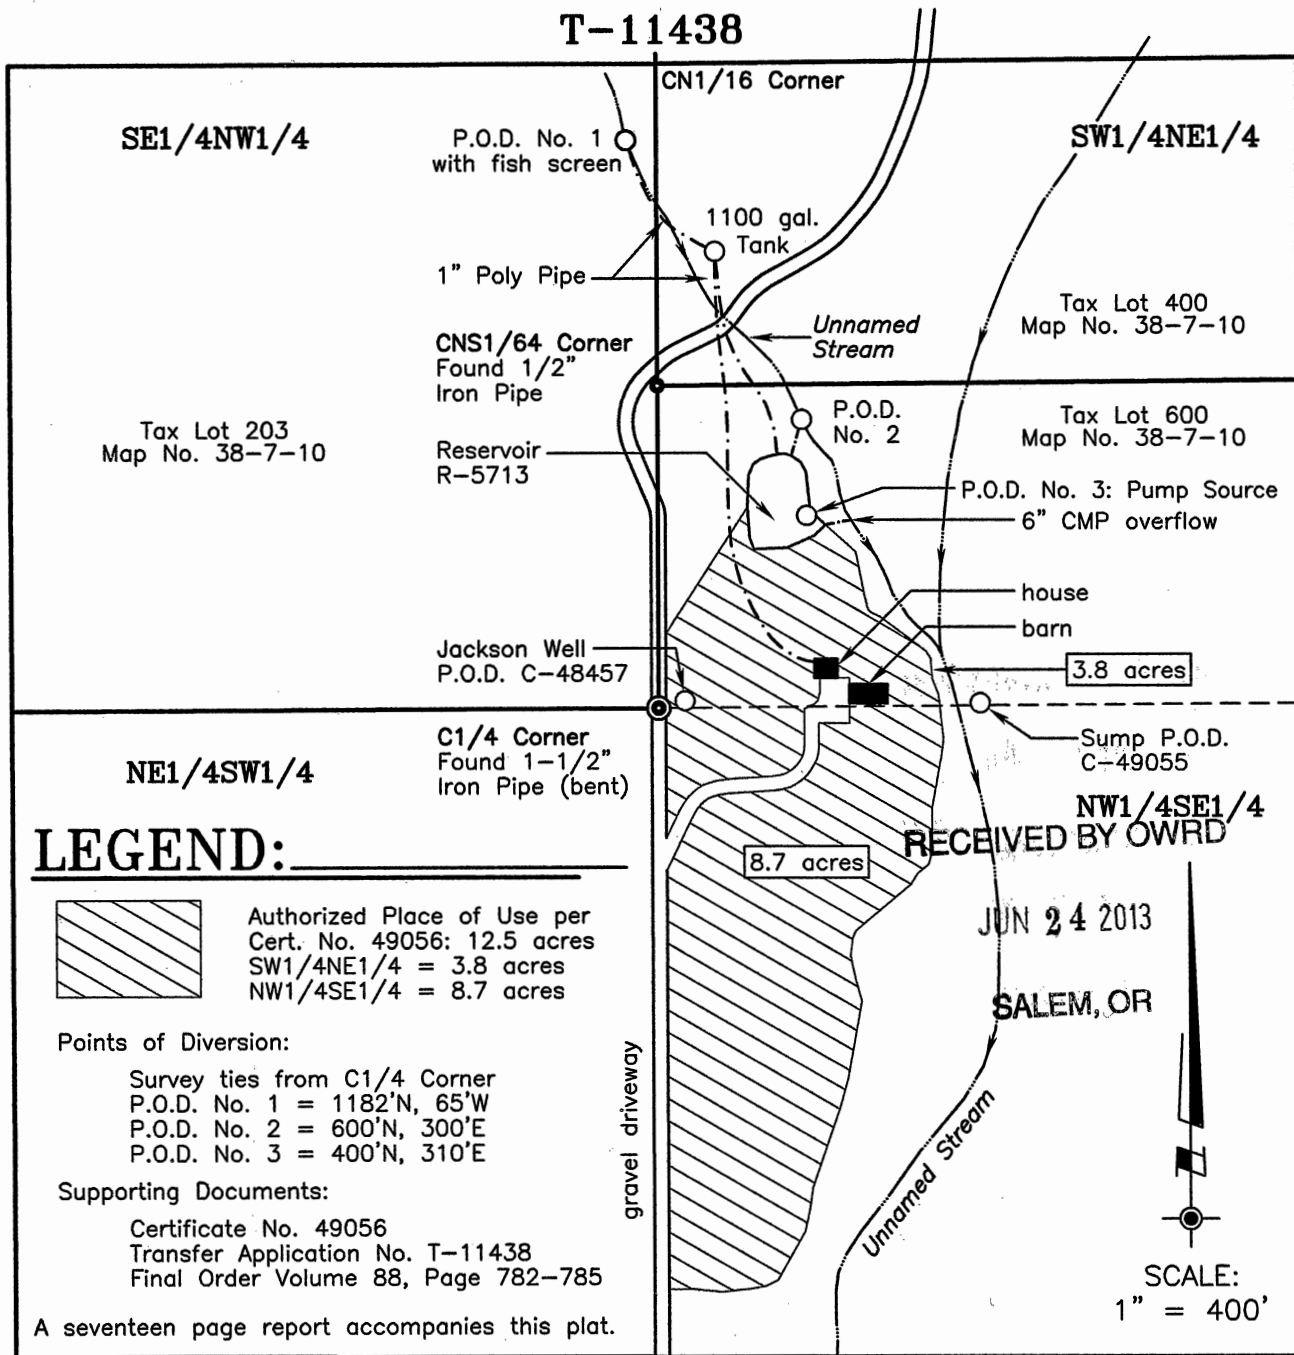

Certificate No. 49056 is canceled.
This plat was prepared for the purpose of identifying the location of the water right only.
There is no intent to provide dimensions or locations of property ownership lines.


PROJECT NO.
1113-13-691

DRAWING NO.
182-8.5.11

DATE:
June 13, 2013

SCALE:
1" = 400'

SHEET NO.
1 of 1

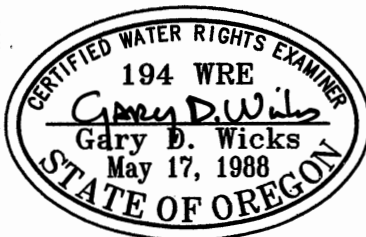

RENEWAL DATE: 6-30-14

PLAT FOR CLAIM OF BENEFICIAL USE

LOCATED IN:
SW1/4NE1/4 and NW1/4SE1/4 of Section 10
Township 38 South, Range 7 West, W.M.
Josephine County, Oregon

PREPARED FOR:
Martin & Sandra Hertler
5980 Deer Creek Road
Selma, OR 97538

Tel: 541-597-4610

PREPARED BY:
WICKS ENGINEERING & SURVEYING
311 N.E. "D" Street
Grants Pass, OR 97526

Tel: 541-479-3436
Fax: 541-479-1014