

Point of diversion "A" is 1017 W and 705' N of East 114 Corner of Section 36
 Point of diversion "B" is 1017' W and 904' N of East 114 Corner of Section 36


APP # R-84738
 Permit # R-13529

Topographic Lines

Wetlands



T.1S, R.1E, W.M., Clackamas County, Oregon
 SE 1/4, NE 1/4 SEC. 36 Tax Lots
 3900, 6000, 6505 & 6600

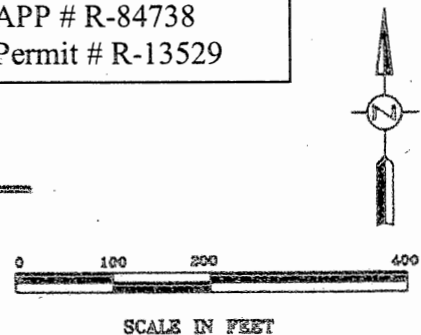

RECEIVED BY OWRD

FEB 29 2016

SALES