


Tax Lot No. TL1000 23 13 35BB

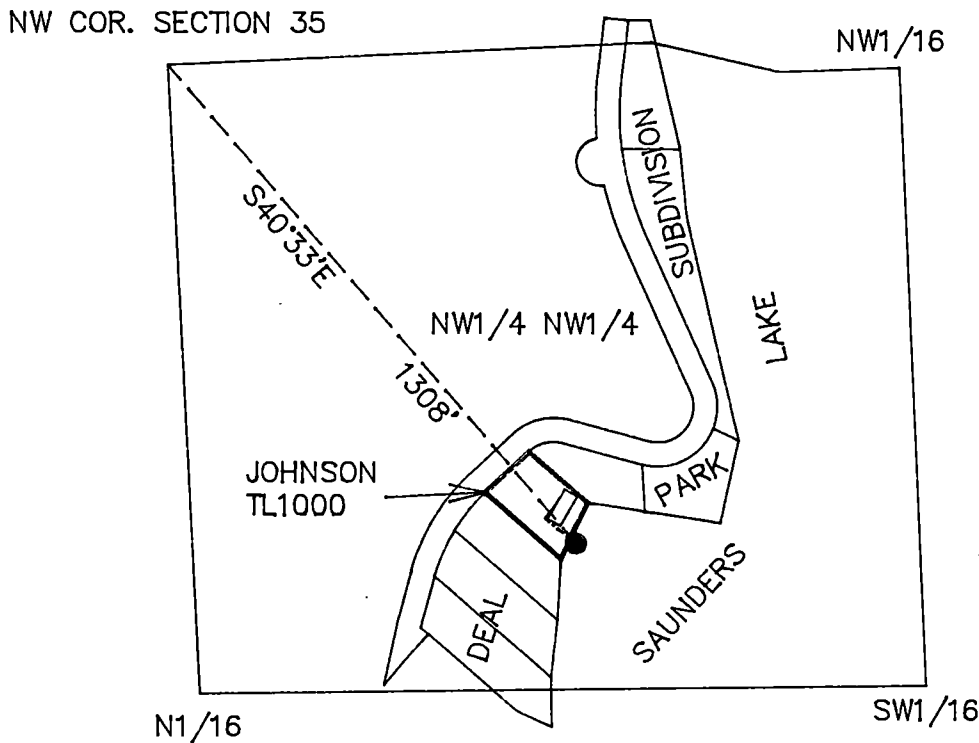



Section 35 Township 23 South, Range 13 West, W.M.

Coos County



Scale 1" = 400'

LEGEND

-  HOME
-  POINT OF DIVERSION & FISH SCREEN
-  WATERLINE
-  PROPERTY LINE

NO FISH BYPASS: THE POD IS A FOOT VALVE HANGING FROM A DOCK AND DOES NOT IMPEDE FISH PASSAGE.
 NO WATER METER REQUIRED
 NO WATER MEASURING DEVICE REQUIRED

EXAMINERS DISCLAIMER STATEMENT

The preparation of this map was for the purpose of identifying the location of the Water Right only and has no intent to provide dimensions or location of property ownership lines.

FINAL PROOF SURVEY

IN THE NAME OF

Marcelle E. Johnson


Surveyed on 6/24/11 by H.A. Wilcox

Application No. S-73819
 Permit No. S-52127

RECEIVED

JUL 29 2011

WATER RESOURCES DEPT
SALEM, OREGON

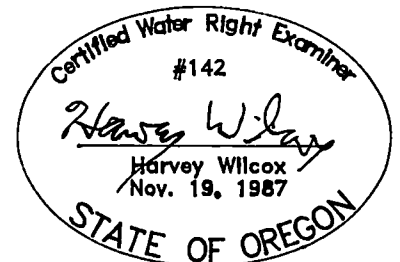

RENEWAL 6/30/12