

POINT OF DIVERSION WITH FISH SCREEN
 NORTH 3344' AND WEST 2610' FROM THE
 SOUTHEAST CORNER OF SECTION 22

NOTES

THIS IS A CLAIM OF BENEFICIAL USE
 MAP TO ACCOMPANY APPLICATION
 NUMBER S-88014, PERMIT NUMBER
 S-54934.


THE PURPOSE OF THIS MAP IS TO
 SHOW THE LOCATION OF THE POINT
 OF DIVERSION, THE PIPELINES, THE
 WATER TANK, AND THE HOUSE IN
 RELATION TO EACH OTHER.

THIS MAP DOES NOT CONSTITUTE A
 BOUNDARY SURVEY AND IS NOT
 INTENDED TO PROVIDE LEGAL
 DIMENSIONS OR LOCATIONS OF
 PROPERTY OWNERSHIP LINES. FOR
 BOUNDARY INFORMATION SEE MAP
 B-3604, TILLAMOOK COUNTY SURVEY
 RECORDS.

TAX LOT 400, THE WATERLINE, AND
 THE POINT OF DIVERSION ARE ALL
 WITH IN GOVERNMENT LOT 3.

LEGEND

- w — WATERLINE
- T 500 GALLON WATER TANK
- H HOUSE

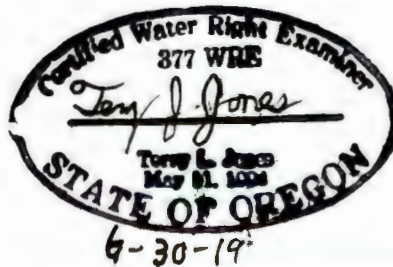

RECEIVED BY OWRD

AUG 24 2017

SALEM, OR

SITE\DARNL-WR.DWG
 DAVE-DARN.CR5

SURVEY BY:
BAYSIDE SURVEYING ©
 11765 HWY 101 SOUTH
 TILLAMOOK, OR. 97141
 (503) 842-5551

WATER RIGHTS MAP FOR:
DAVID DARNALL
 INSTRUMENT #2014-2083
 TAX LOT 400
 SW 1/4 NE 1/4 (GOV LOT 3),
 SECTION 22, T1S, R10W, W.M.
 TILLAMOOK COUNTY, OREGON

DATE	EQUIPMENT	FIELD	DRAWN	CHECKED	JOB NO.
JAN. 16, 2017	TOPCON ES-103 SPECTRA NOMAD	TLJ/DMM	DWE	TLJ	