



CERTIFIED WATER RIGHT EXAMINER
 40411
Mark Alan Yeager
 MARK ALAN YEAGER
 JUNE 12, 2008
 STATE OF OREGON

Place of Use
Urban Growth Boudary
Township, Range
Sections

This map was not intended to provide legal dimensions or locations of property ownership lines.

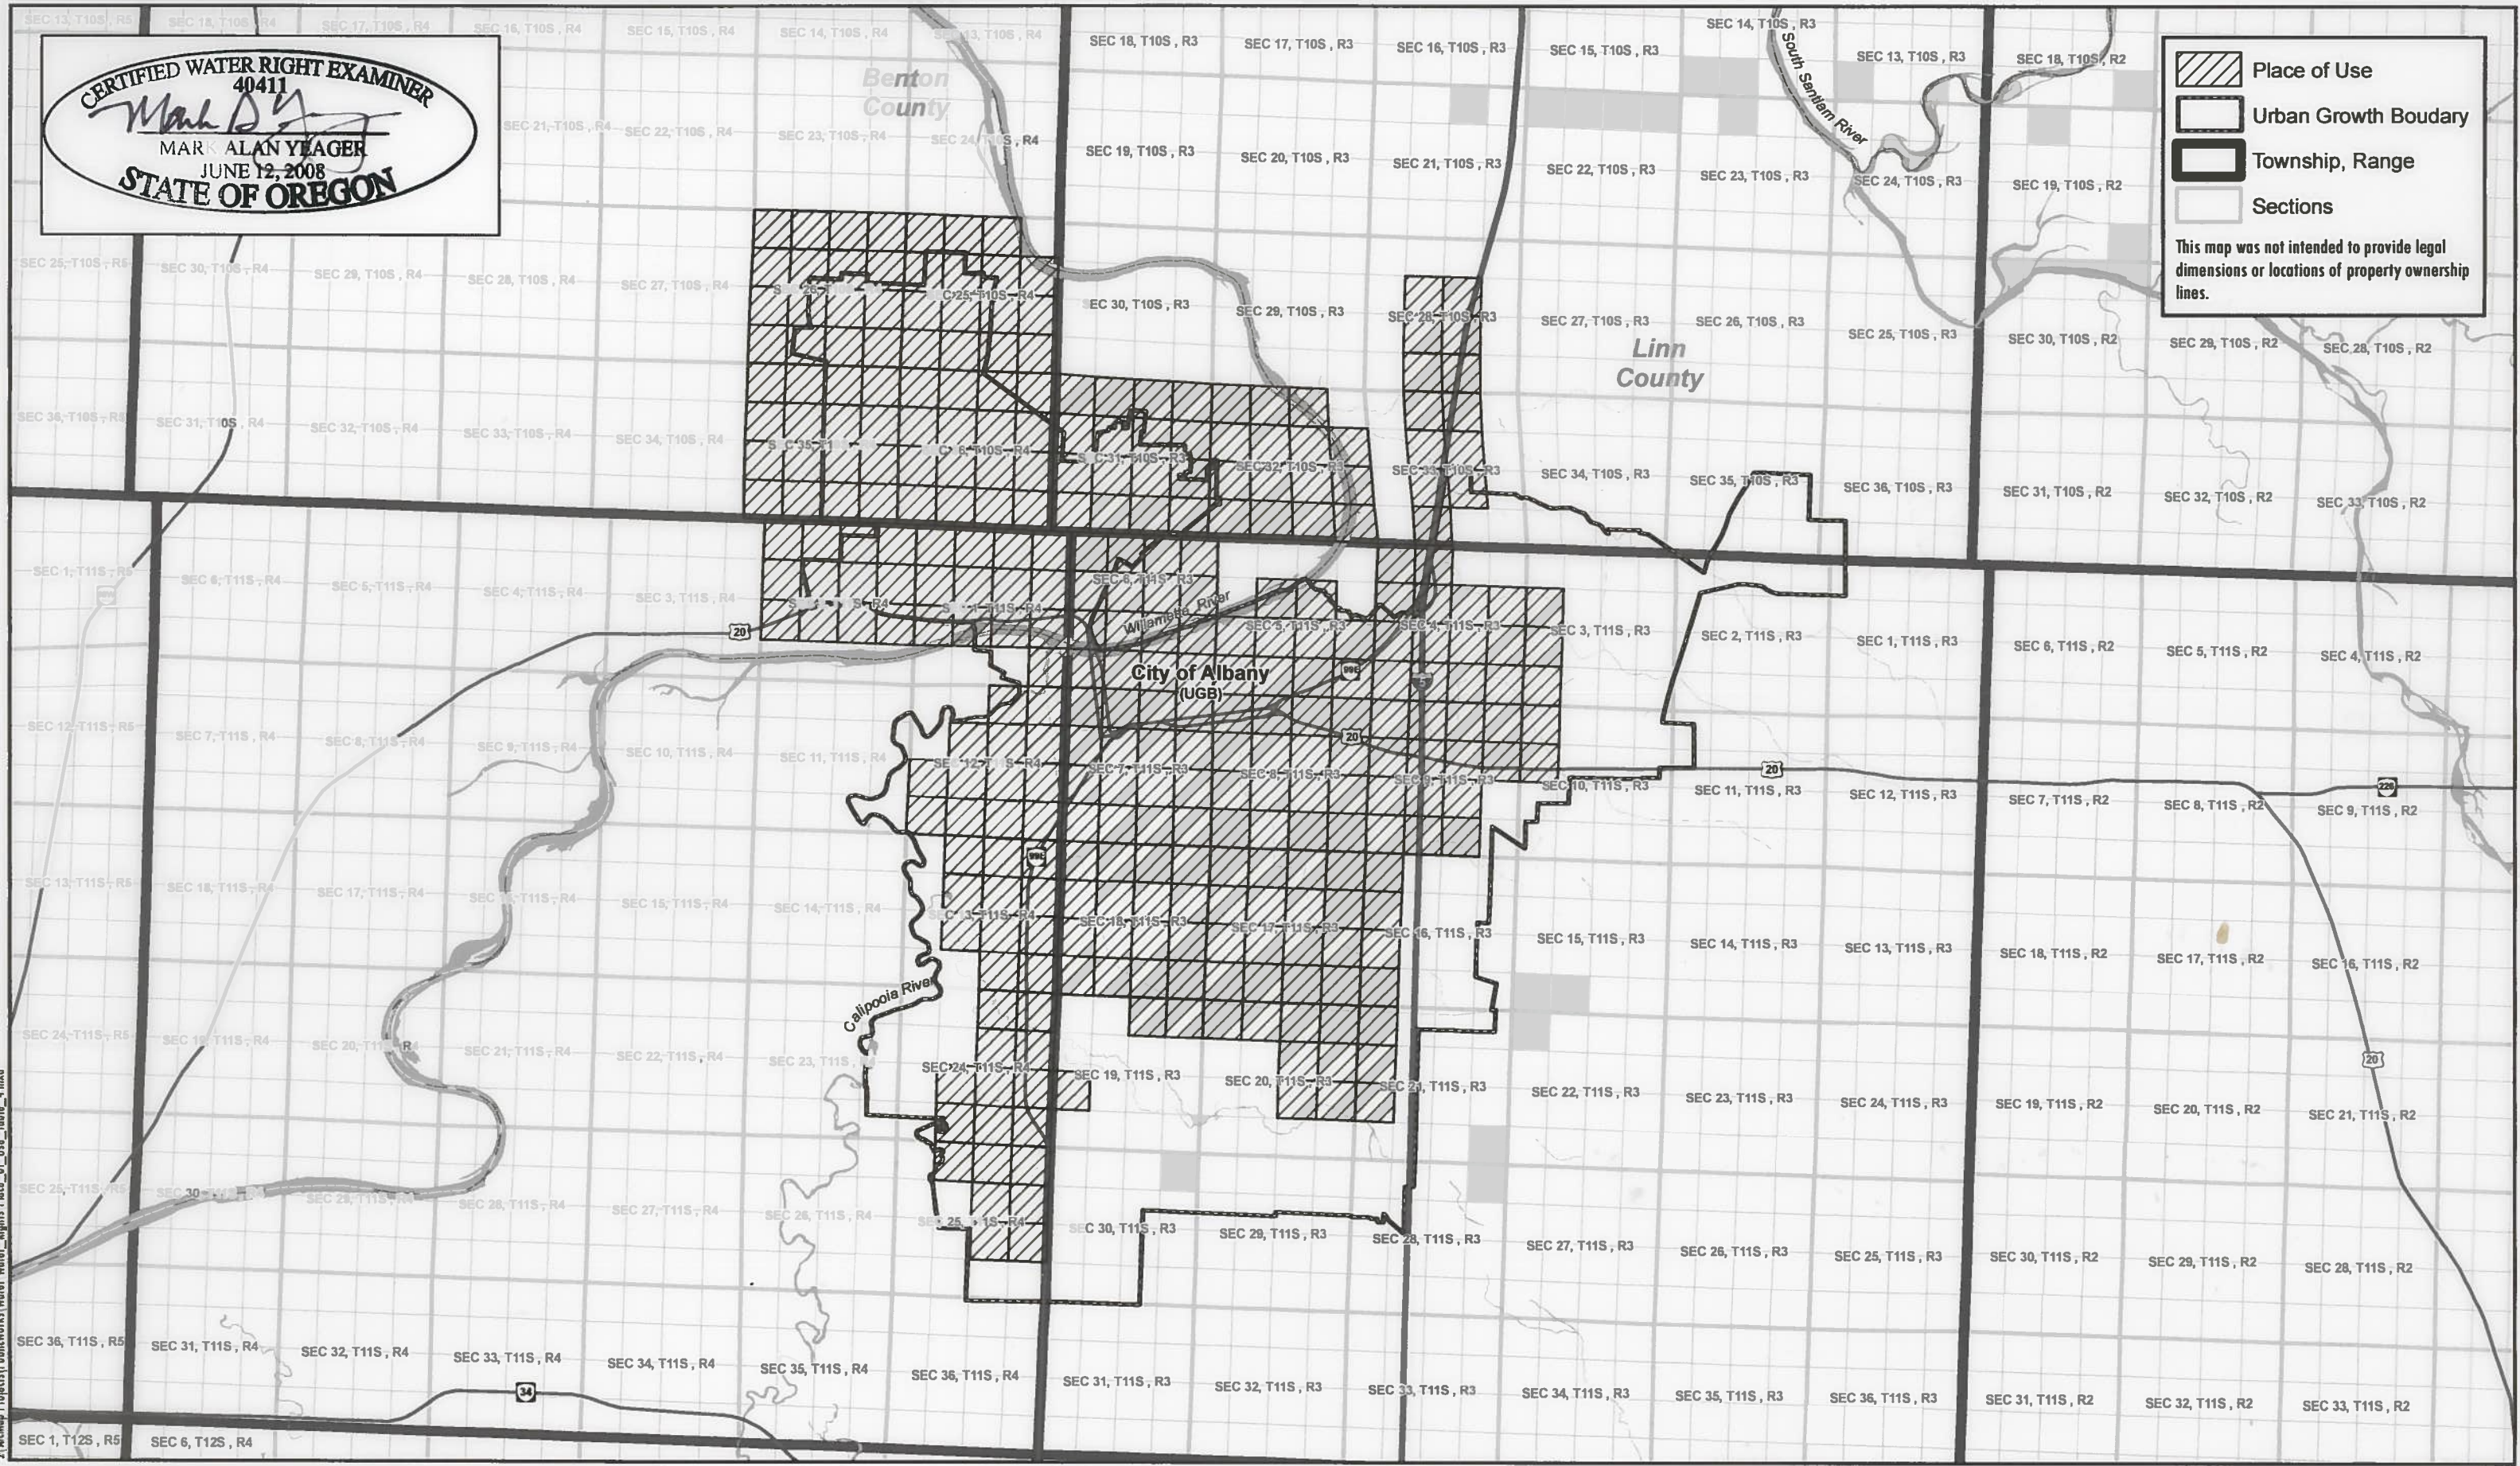

H:\Map\Projects\Public\Works\Water_Rights\Place_of_Use_Table_4.mxd

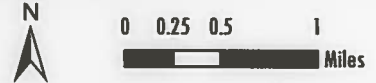

COBU MAP #1032

RECEIVED BY OWRD

DEC 08 2016

Place of Use Map

Date: 11/14/2016

City of Albany / Claim of Beneficial Use Application #C-58006 / Permit #C-44388