



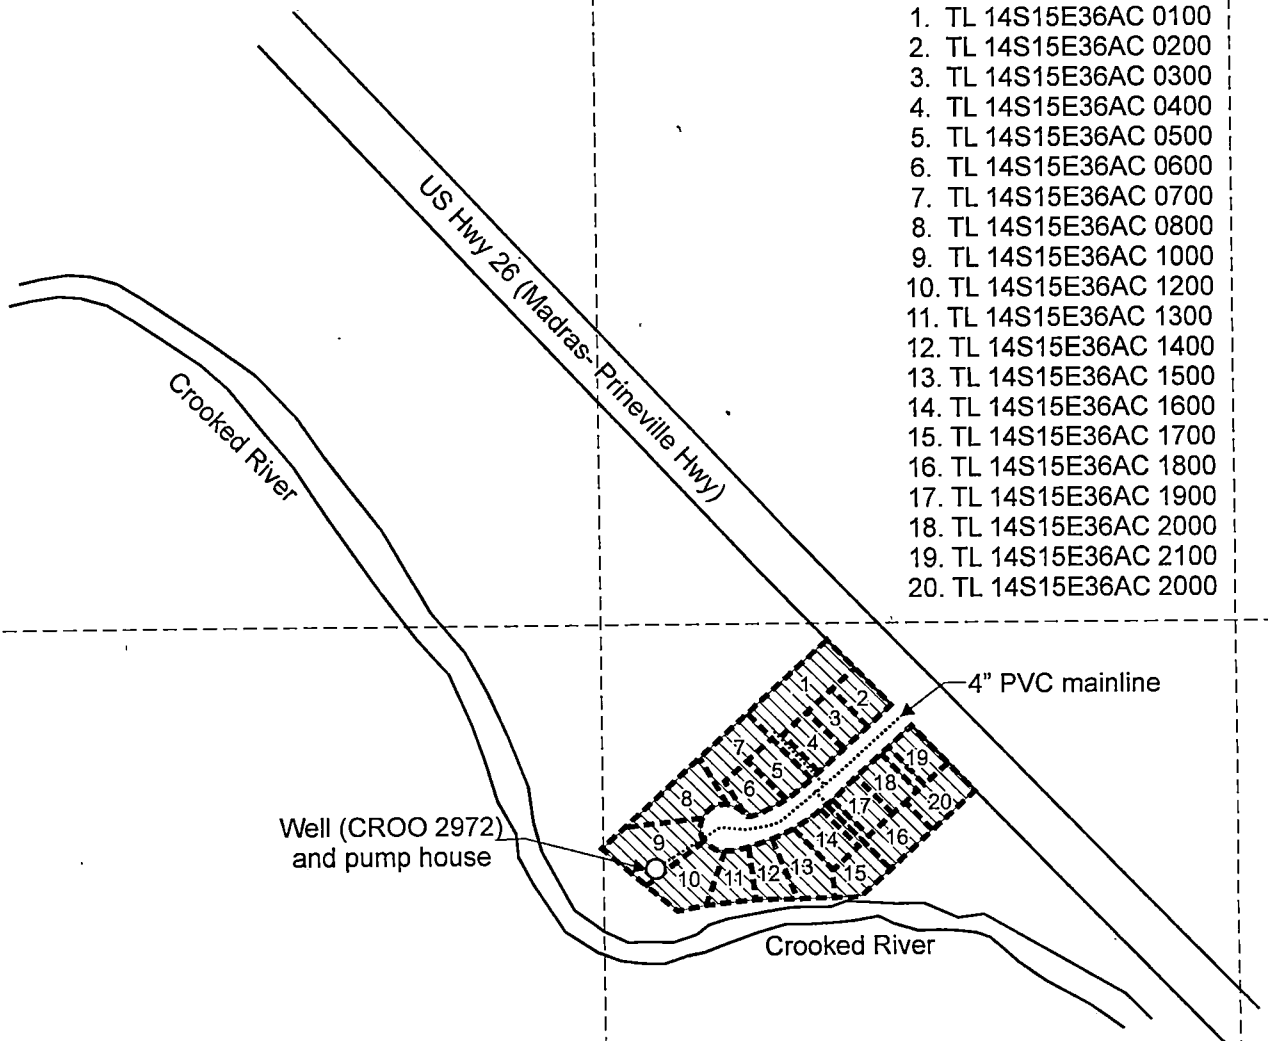


T.14S. R.15E. Section 36, W.M.

1. TL 14S15E36AC 0100
2. TL 14S15E36AC 0200
3. TL 14S15E36AC 0300
4. TL 14S15E36AC 0400
5. TL 14S15E36AC 0500
6. TL 14S15E36AC 0600
7. TL 14S15E36AC 0700
8. TL 14S15E36AC 0800
9. TL 14S15E36AC 1000
10. TL 14S15E36AC 1200
11. TL 14S15E36AC 1300
12. TL 14S15E36AC 1400
13. TL 14S15E36AC 1500
14. TL 14S15E36AC 1600
15. TL 14S15E36AC 1700
16. TL 14S15E36AC 1800
17. TL 14S15E36AC 1900
18. TL 14S15E36AC 2000
19. TL 14S15E36AC 2100
20. TL 14S15E36AC 2000

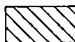


Well (CROO 2972) is located 1,828 feet south and 108 feet east from the N 1/4 corner of Section 36.

-  Group Domestic Area (20 Sites)
-  Tax lot boundary
-  Mainline

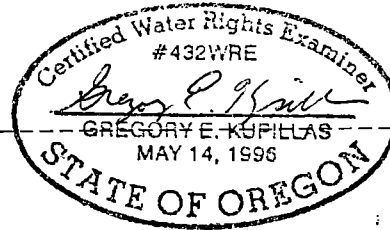


EXPIRATION DATE: 6/30/2015

Scale: 1" = 400'

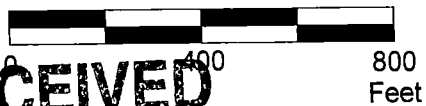

This map was prepared for the purpose of identifying the location of a water right only and is not intended to provide legal dimensions or location of property ownership lines.

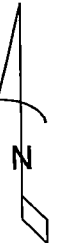

McDougal BU.cdr

RECEIVED

JUL 18 2013

Pacific Hydro-Geology Inc.
WATER RESOURCES DEPT
SALEM, OREGON

06/2013

Claim of Beneficial Use Map
Application G-13556, Permit G-13516

McDougal Water System
T.14S. R.15E. Section 36, W.M.