TOWNSHIP 34 SOUTH, RANGE 8 WEST, W.M.

JOSEPHINE COUNTY, OREGON

CLAIM OF BENEFICIAL USE

T-9468

IN THE NAME OF:
DEBBIE L. THOMASON

SECTION 36, T.34S., R.8W., W.M.

RECEIVED BY COURT
DEC 30 2015
SALEM, OR

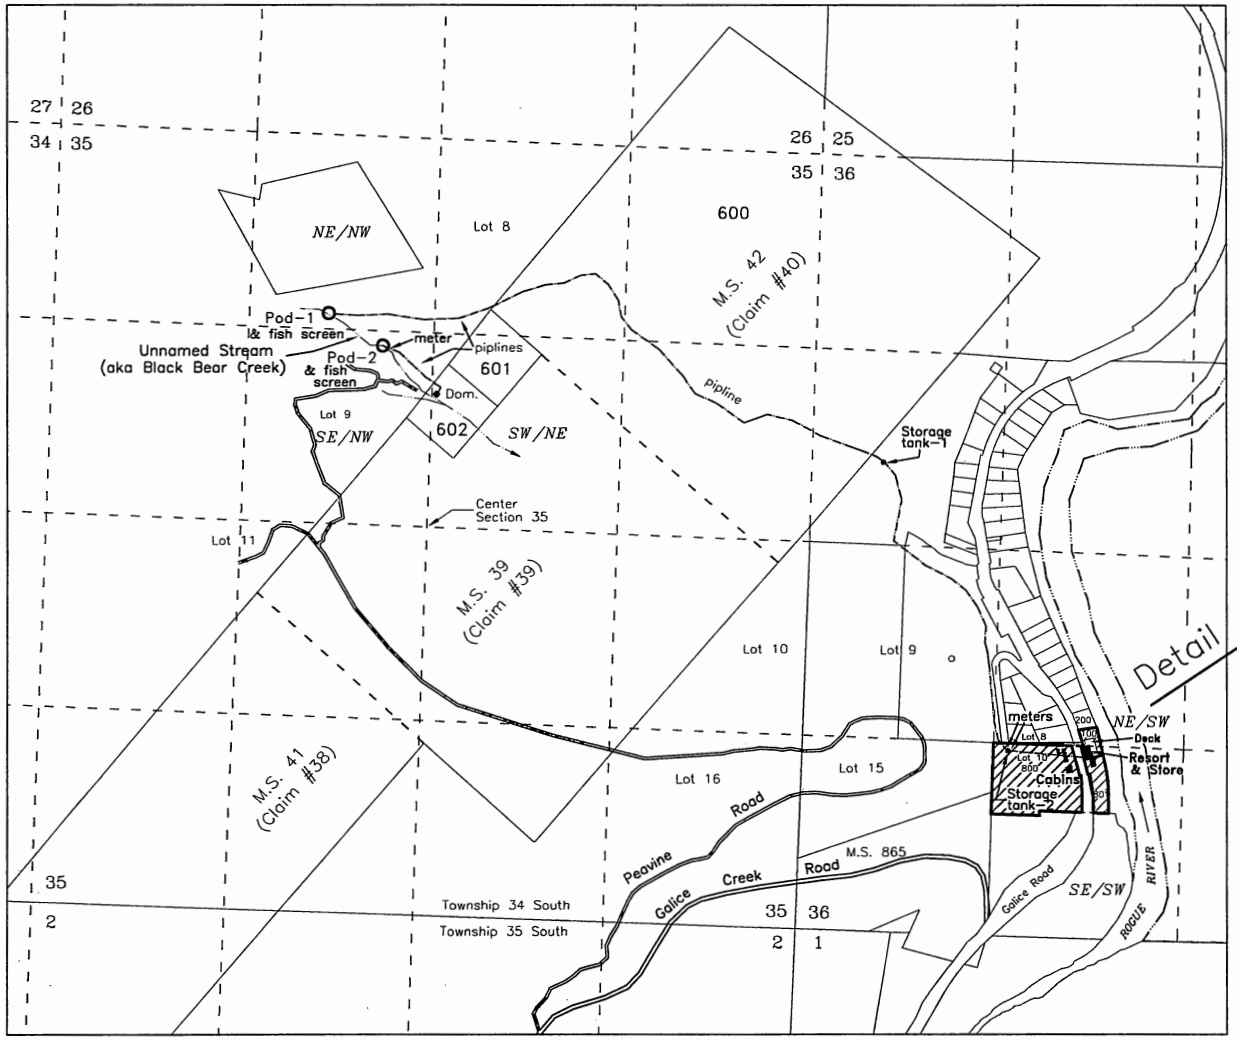

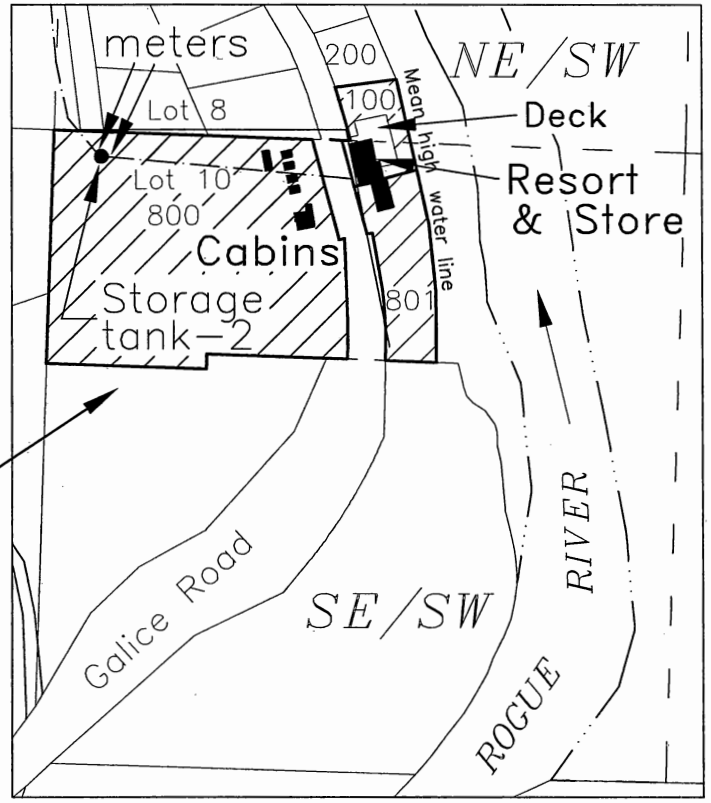

Scale: 1 inch = 1320 feet

Scale: 1 inch = 400 feet

- Dom. – Domestic Use, SW/NE Section 35

Commercial Uses, NE/SW & SE/SW Section 36

- POD-1 Commercial Uses – NE/NW Section 35 1200 feet South and 3440 feet West from the Northeast Corner Section 35
- POD-2 Domestic Use – SE/NW Section 35 1230 feet North and 350 feet West from the Center Corner Section 35

POD coordinates per previous water right surveys

Pipeline location is approximate

This map is not intended to provide legal dimensions or locations of property ownership lines

CERTIFIED WATER RIGHTS EXAMINER
431WRE
6-30-17
KENNA CLAY JORDAN
5-14-08
STATE OF OREGON

Base map – Josephine County GIS and Partition Map 1992-4
2005 FSA & 2007 Google Aerials

NORTH

Commercial Uses
NE/SW & SE/SW
Section 36

JORDAN ENGINEERING
460 JORDAN LANE
ROSEBURG, OR 97471
(541) 673-1931

6/1/2010 n.e.d.

rev-4-5/6/2015 n.e.d.