


T.18S. R.8E. Section 32, W.M.

RECEIVED

SEP 13 2013

WATER RESOURCES DEPT
SALEM, OREGON

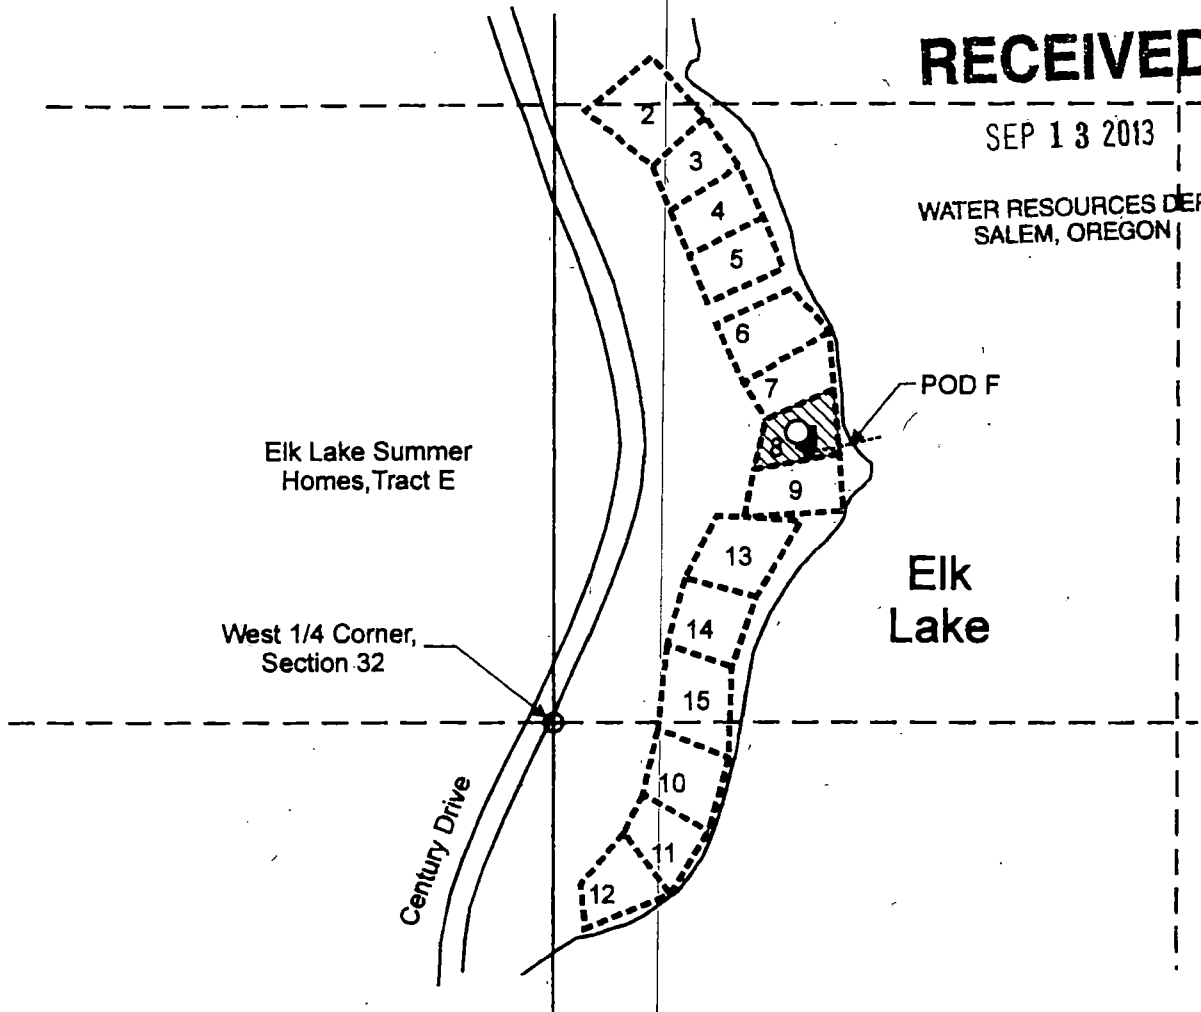

POD F is located 590 feet north and 630 feet east from the W1/4 corner, Section 32.

Area of use for Human Consumption.


----- Tax lot boundary

■ Cabin Location

○ Pump Location


● Meter Location

----- Mainline

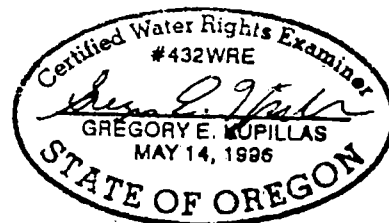

EXPIRATION DATE: 6/30/2015

Scale: 1" = 400'

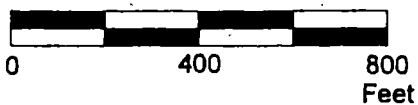

This map was prepared for the purpose of identifying the location of a water right only and is not intended to provide legal dimensions or location of property ownership lines.

Claim of Beneficial Use Map
Application S-87485, Permit S-54634

Elk Lake Track E - POD F
T.18S. R.8E. Section 32, W.M.

Pacific Hydro-Geology Inc.

11/2011

T.18S. R.8E. Section 29 & 32, W.M.


RECEIVED

SEP 13 2013

WATER RESOURCES DEPT
SALEM, OREGON

SE Corner of the
SW1/4 SE1/4,
Section 29

NE Corner of the
NW1/4 NE1/4,
Section 32


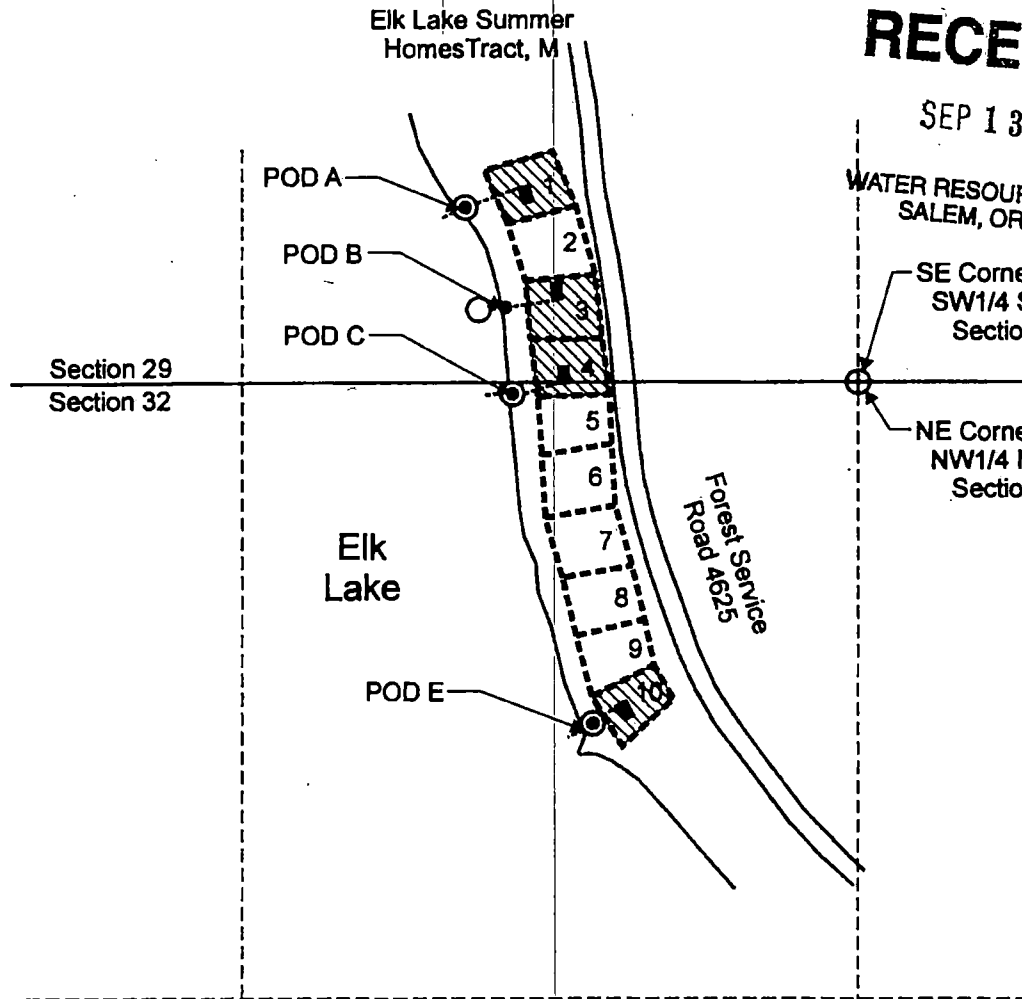


POD A is located 370 feet north and 860 feet west from the SE corner of the SW1/4 SE1/4, Section 29.
POD B is located 160 feet north and 770 feet west from the SE corner of the SW1/4 SE1/4, Section 29.
POD C is located 30 feet south and 750 feet west from the NE corner the NW1/4 NE1/4, Section 32.
POD E is located 750 feet south and 590 feet west from the NE corner the NW1/4 NE1/4, Section 32.

Note: PODs located at shoreline at time of site inspection and are subject to change depending on lake levels.

- Location of use for Human Consumption.
- Tax lot boundary
- Pump Location
- Meter Location
- Mainline

Scale: 1" = 400'

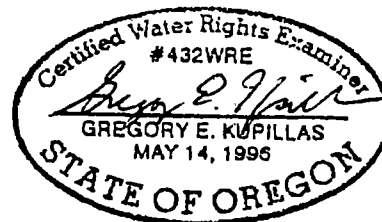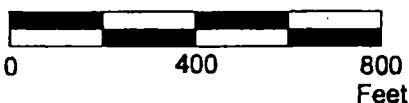

EXPIRATION DATE: 6/10/2015

This map was prepared for the purpose of identifying the location of a water right only and is not intended to provide legal dimensions or location of property ownership lines.

Claim of Beneficial Use Map
Application S-87485, Permit S-54634

Elk Lake Tract M - PODs A, B, C, and E
T.18S. R.8E. Section 29, 32, W.M.

Pacific Hydro-Geology Inc.

11/2011