

T24S, R07E,
SECTION 7, WM

KLAMATH COUNTY, OREGON




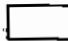


MAP 1 OF 3



0 400 Feet
1" = 400'

RECEIVED BY OWRD


AUG 05 2016

-  POU Quasi-Municipal Use
-  Section
-  Quarter Quarter
-  Tax Lot
-  Pipeline
-  Well & meter


RECEIVED BY OWRD

APR 03 2017

SALEM, OR

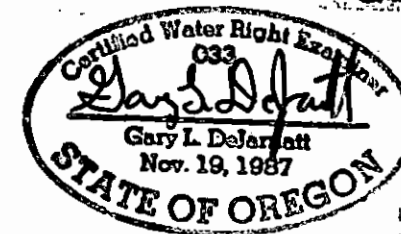

RENEWAL DATE 12/31/2017

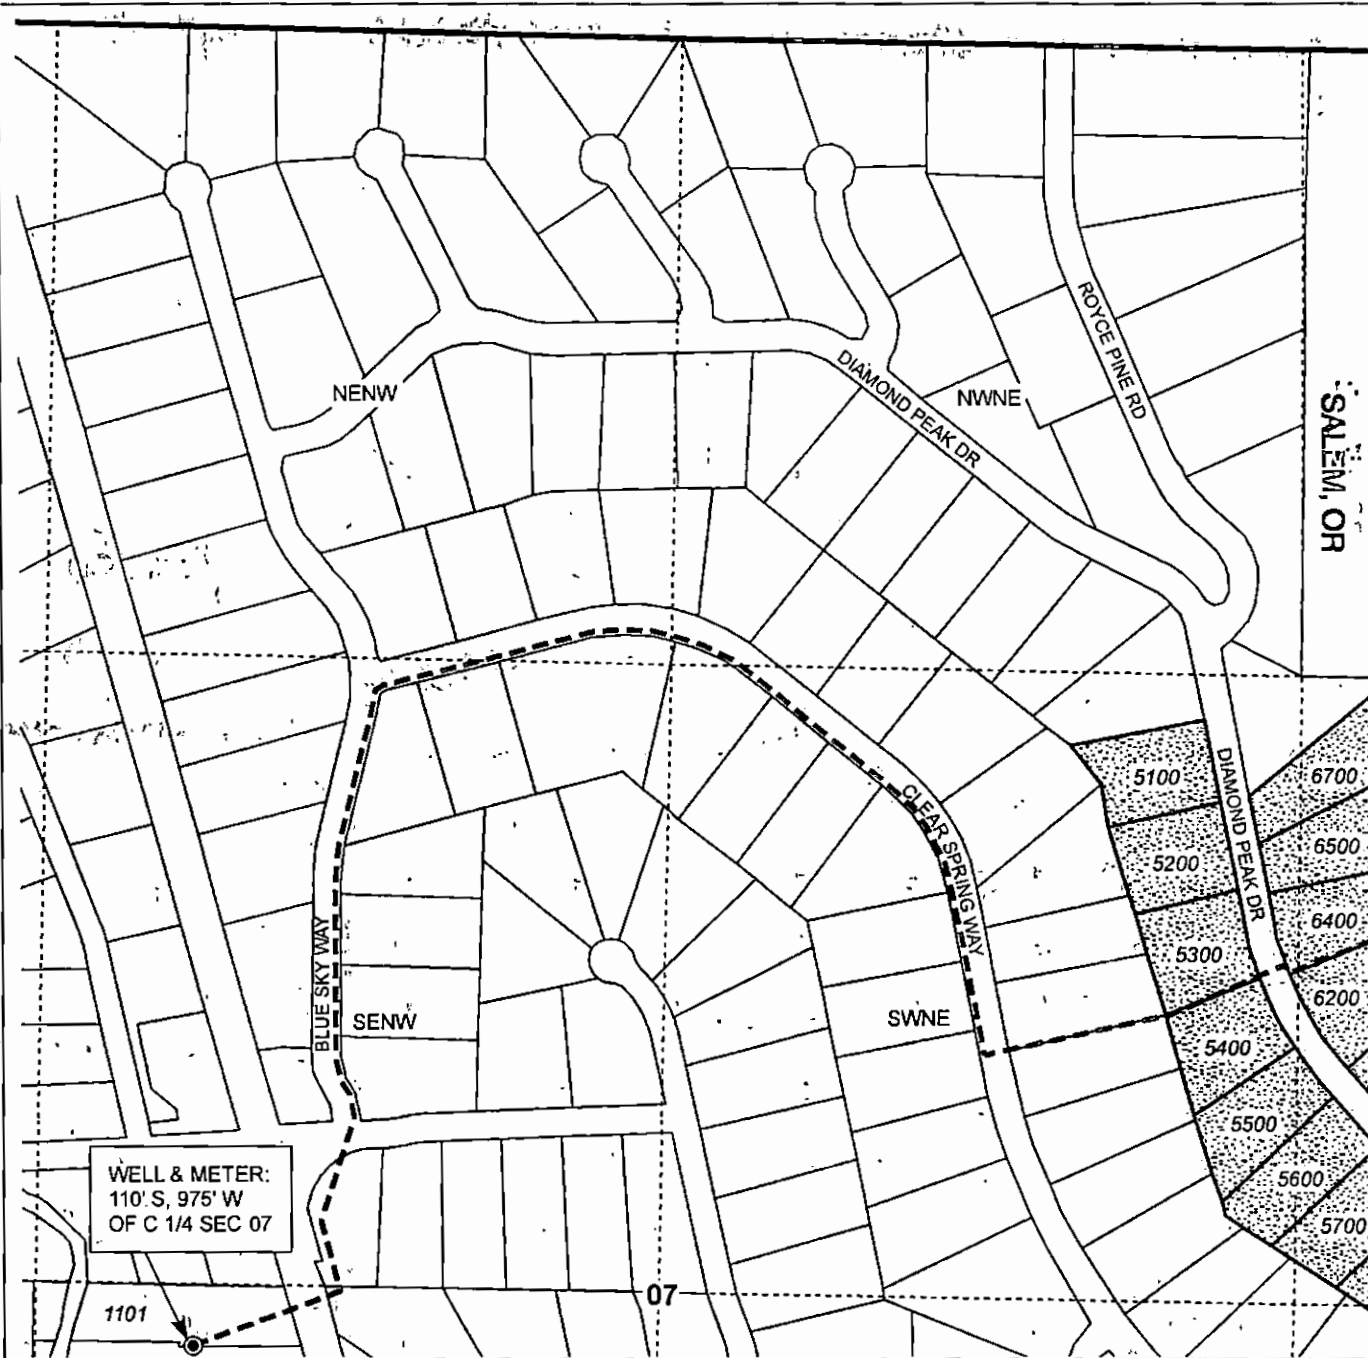

WELL & METER:
110' S, 975' W
OF C 1/4 SEC 07

1101

07

CLAIM OF BENEFICIAL USE
Diamond Summit HOA

NOTE: THIS MAP IS NOT INTENDED TO
PROVIDE LEGAL DIMENSIONS OR LOCATIONS
OF PROPERTY OWNERSHIP LINES.

WATER RIGHT SERVICES, LLC
PO BOX 1830, BEND, OR 97709
CCB# 197121 www.oregonwater.us
541-389-2837 JOHNSHORT@USA.COM

AP G-17415

PERMIT G-17617


PROJECT #15098

JULY 12, 2016

**T24S, R07E,
SECTION 7, WM**


KLAMATH COUNTY, OREGON




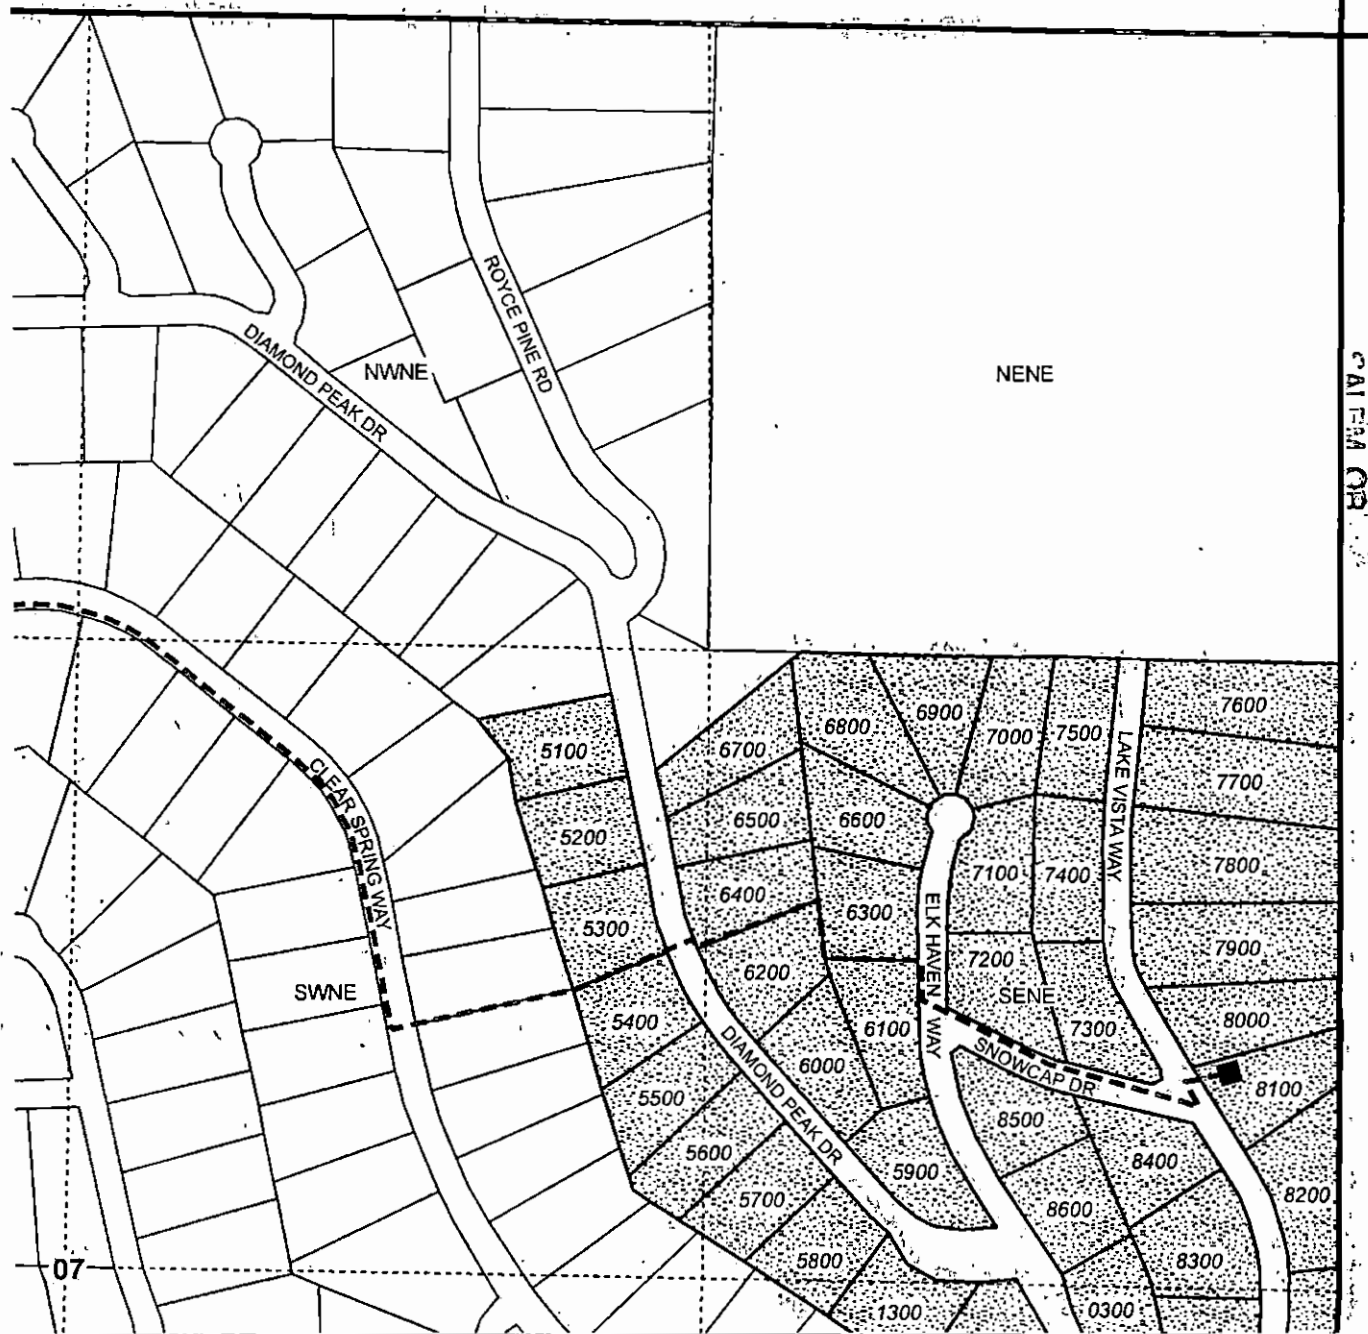


MAP 2 OF 3

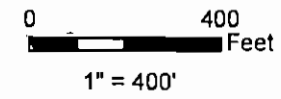




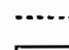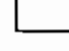

-  POU Quasi-Municipal Use
-  Section
-  Quarter Quarter
-  Tax Lot
-  Pipeline
-  Cistern

RECEIVED BY OWHD

APR 08 2017

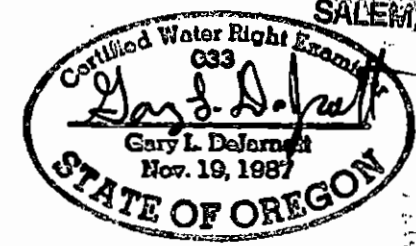

SALEM, OR



RENEWAL DATE 12/31/2017

CLAIM OF BENEFICIAL USE
Diamond Summit HOA

-NOTE: THIS MAP IS NOT INTENDED TO
PROVIDE LEGAL DIMENSIONS OR LOCATIONS
OF PROPERTY OWNERSHIP LINES.


WATER RIGHT SERVICES, LLC
PO BOX 1830, BEND, OR 97709
CCB# 197121 | www.oregonwater.us
541-389-2837 | JOHNSHORT@USA.COM

AP G-17415

PERMIT G-17617

PROJECT #15098

JULY 12, 2016

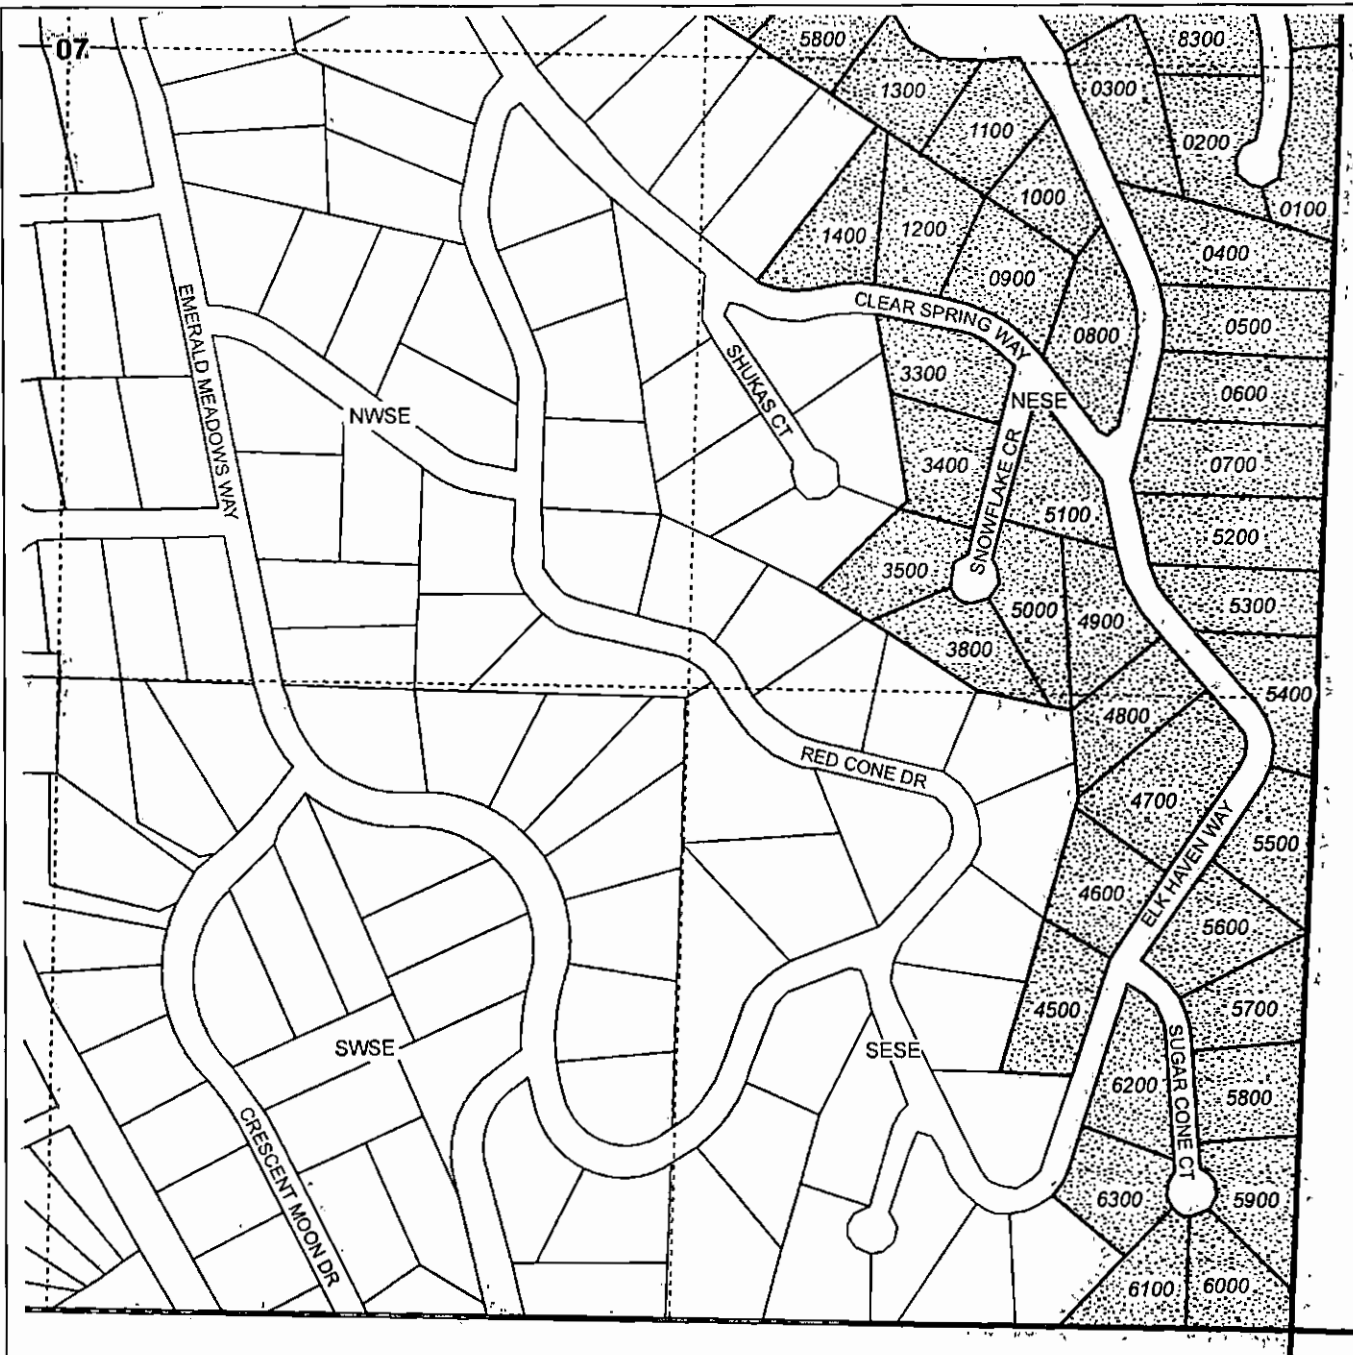


T24S, R07E,
SECTION 7, WM
KLAMATH COUNTY, OREGON

MAP 3 OF 3

SALEM, OR

AUG 05 2016

RECEIVED BY OWRD

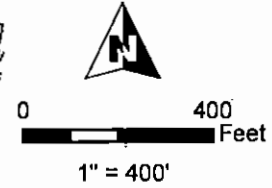


- POU Quasi-Municipal Use
- Section
- Quarter Quarter
- Tax Lot

RECEIVED BY OWRD

APR 03 2017

SALEM, OR

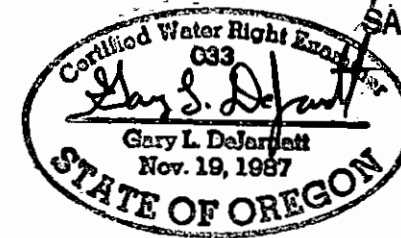

RENEWAL DATE 12/31/2017

CLAIM OF BENEFICIAL USE
Diamond Summit HOA

NOTE: THIS MAP IS NOT INTENDED TO
PROVIDE LEGAL DIMENSIONS OR LOCATIONS
OF PROPERTY OWNERSHIP LINES.

WATER RIGHT SERVICES, LLC
PO BOX 1830, BEND, OR 97709
CCB# 197121 www.oregonwater.us
541-389-2837 JOHNSHORT@USA.COM

AP G-17415

PERMIT G-17617

PROJECT #15098.

JULY 12, 2016