

SE 1/4, SW 1/4, SECTION 35
T. 23 S., R. 13 W., W.M.
COOS COUNTY, OREGON

RECEIVED BY OWRD

APR 07 2014

SALEM, OR

SAUNDERS
LAKE

POINT OF DIVERSION
NORTH 623' & WEST 1135'
FROM THE S. 1/4 CORNER OF
SECTION 35 T. 23 S. - R. 13 W., W.M.

POINT OF
DIVERSION

LAWN AND GARDEN
IRRIGATED AREAS

WATERLINE [L=490']
1-1/2" PVC

TL 800 & 700
"Ridling"



SCALE: 1" = 100'

WILDMOOD DRIVE

HOUSE

TL 900
"Ridling"

HOUSE

TL 1000
"Hansen"


SE 1/4 - SW 1/4
SEC 35

SW 1/4 - SE 1/4
SEC 35

S 1/4 CORNER
SECTION 35

T. 24 S., R. 13 W., SECTION 2

FINAL PROOF SURVEY

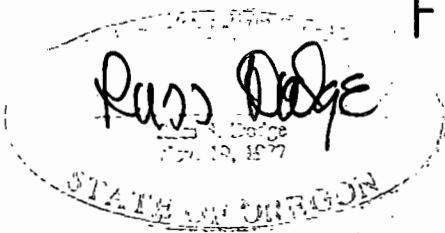

APPLICATION NO S-83444
PERMIT NO S-83444
MARCH 13, 2014

NOTE: THIS MAP WAS PREPARED FOR
THE PURPOSE OF IDENTIFYING THE
LOCATION OF A WATER RIGHT ONLY
AND IS NOT INTENDED TO PROVIDE
LEGAL DIMENSIONS OR LOCATION OF
PROPERTY OWNERSHIP LINES.