

Map of Water Right Transfer

Certificate 44735
T39S, R18E, Section 25 & 26
Page 1

RECEIVED BY OWRD

NOV 21 2016

SALEM, OR



Legend

-  Cert 44735 Unchanged
-  Cert 44735 Trans From
-  Cert 44735 Trans To



1 inch = 1,320 feet

Note: This map is not intended to provide legal dimensions or locations of property ownership lines.

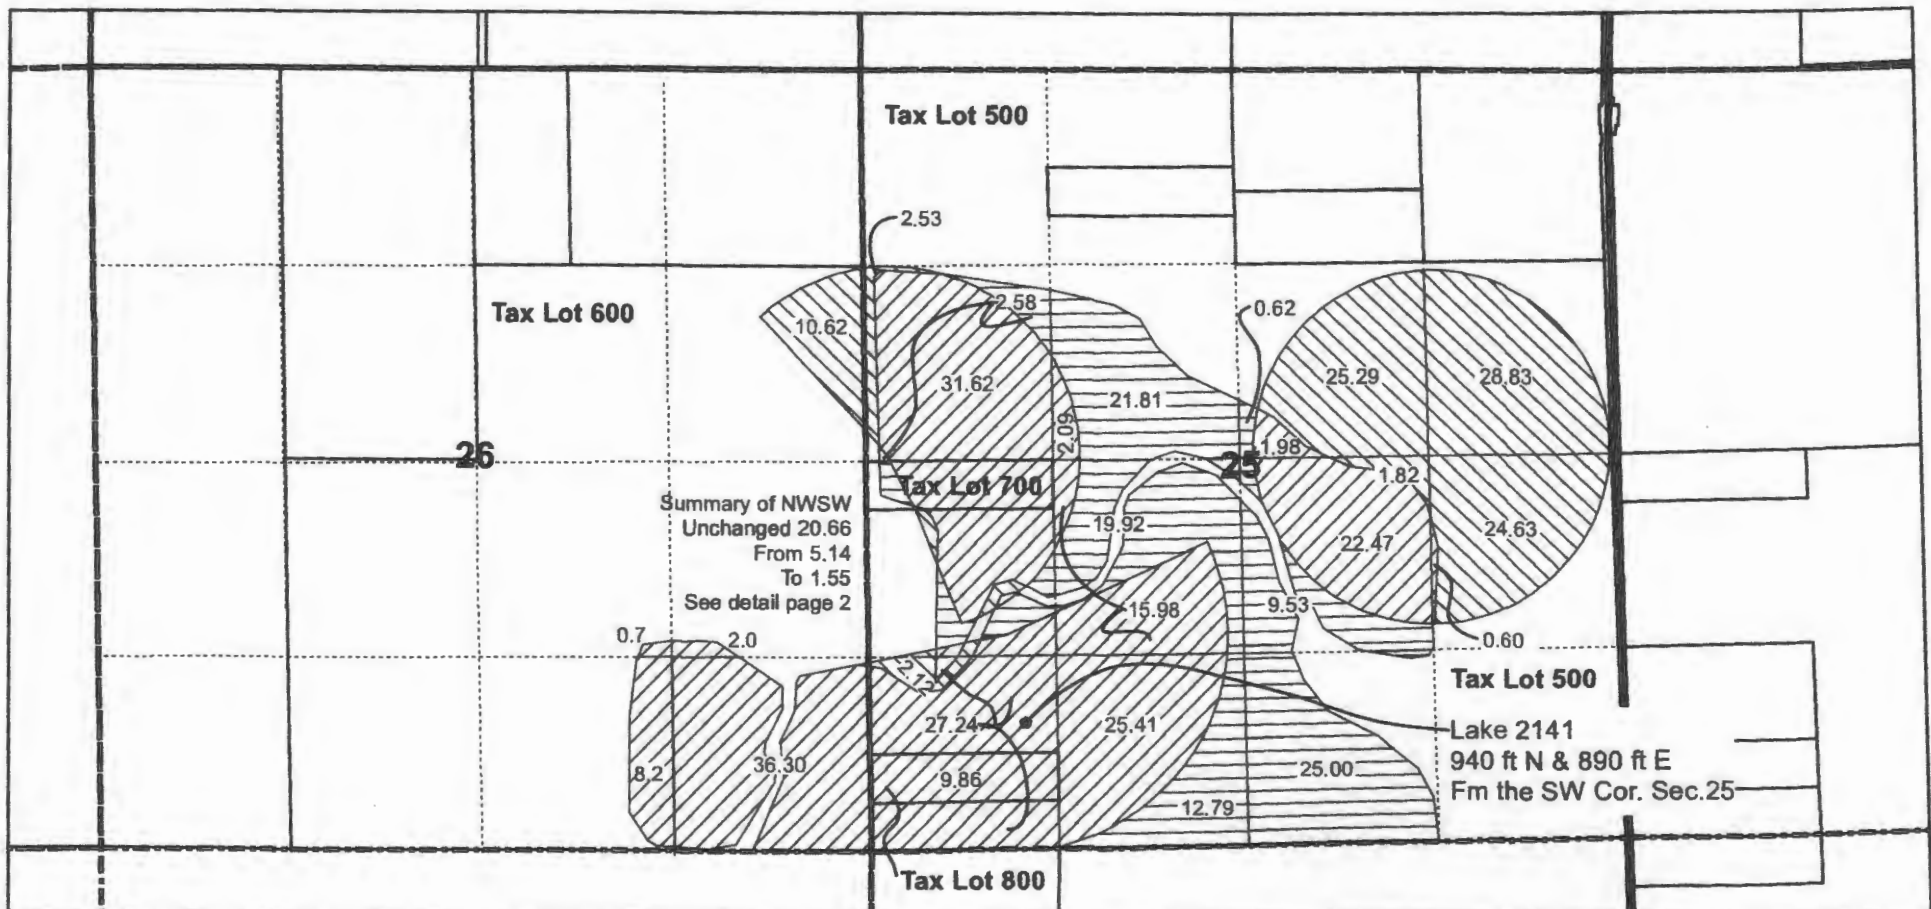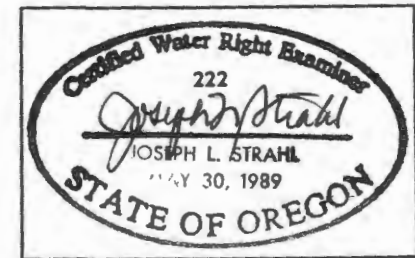

72521-1

RECEIVED BY OWRD

NOV 21 2016

SALEM, OR

Map of Water Right Transfer

Certificate 44735
T39S, R18E, Section 25 & 26
Page 2

Detail of NW SW of Section 25


Legend

-  Cert 44735 Unchanged
-  Cert 44735 Trans From
-  Cert 44735 Trans To



1 inch = 400 feet

Note: This map is not intended to provide legal dimensions or locations of property ownership lines.

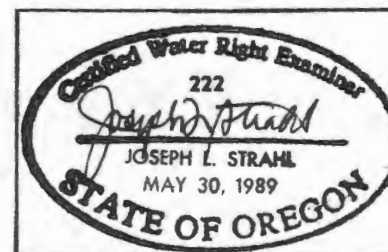


Detail of NW SW of Section 25

Tax Lot 500
Unchanged 10.13
0.14
2.26
0.27
Total 12.80

From 0.71
1.88
1.65
Total 4.24

To 0.53
0.61
0.23
0.16
Total 1.53

Tax Lot 700
Unchanged 7.86
From 0.90
To 0.02

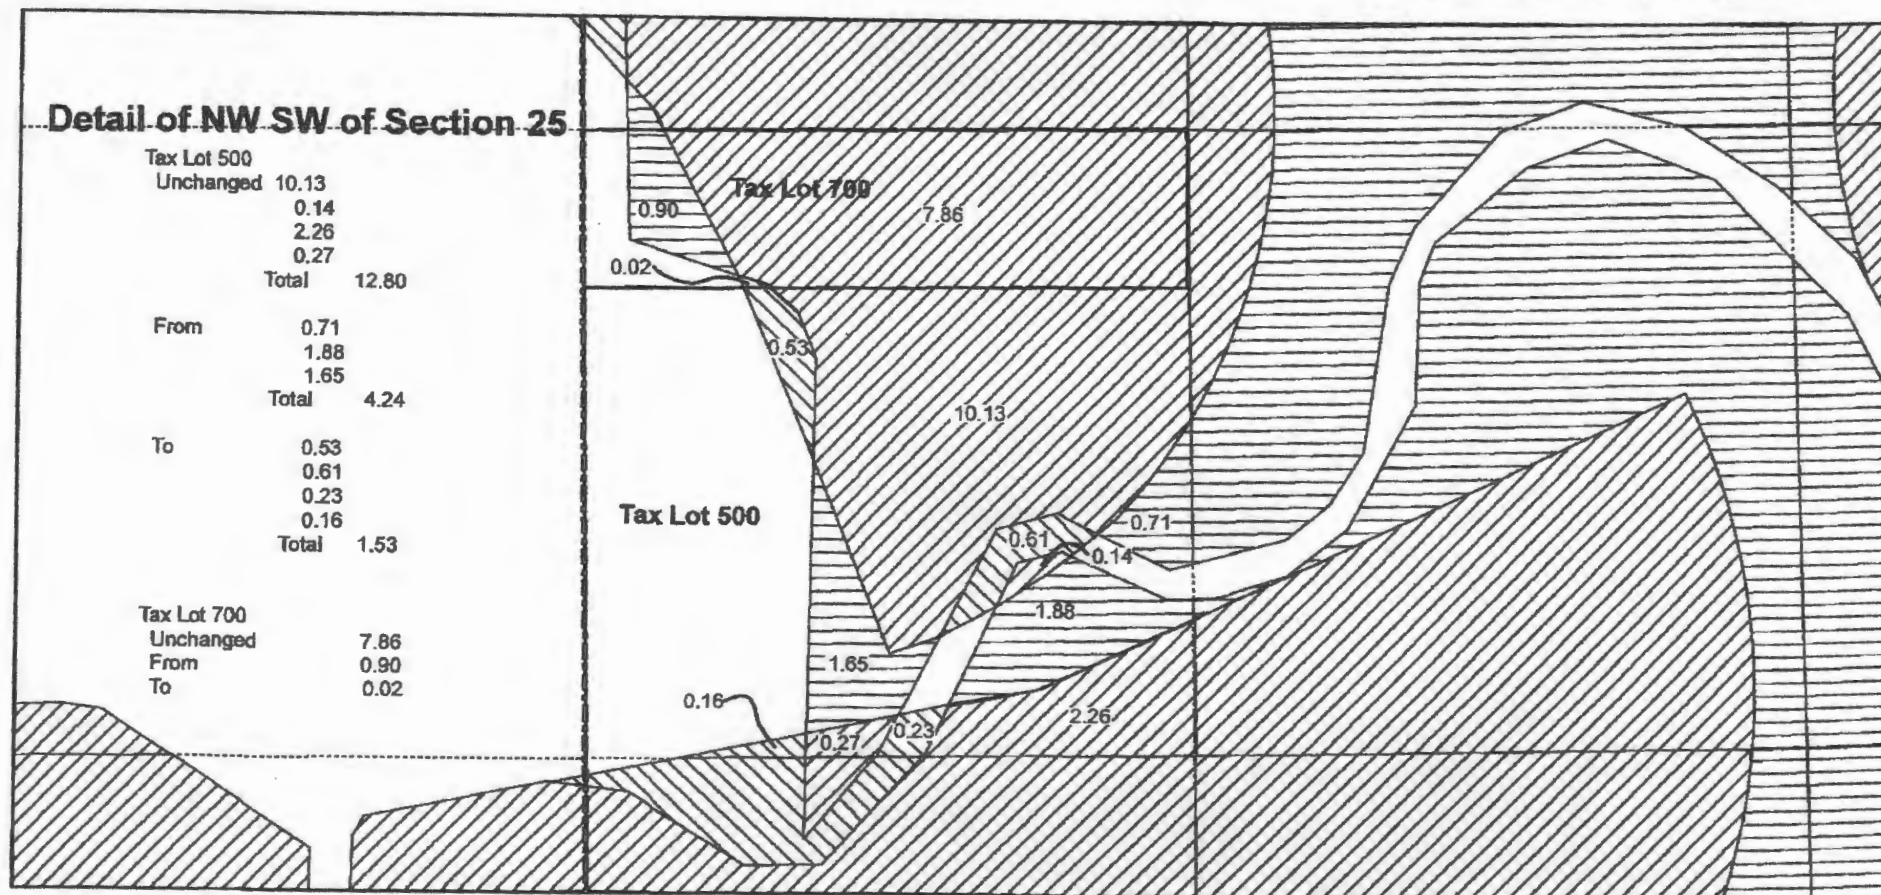

7-10526

44735

26



CNZ-26K-63