


CLAIM OF BENEFICIAL USE MAP
FOR CLOWES FAMILY TRUST
LOCATED IN THE SW1/4 OF THE SW1/4 OF SECTION 20
TOWNSHIP 23 SOUTH, RANGE 12 WEST, W.M.,
COOS COUNTY, OREGON

APPLICATION #S-81597
PERMIT #53310

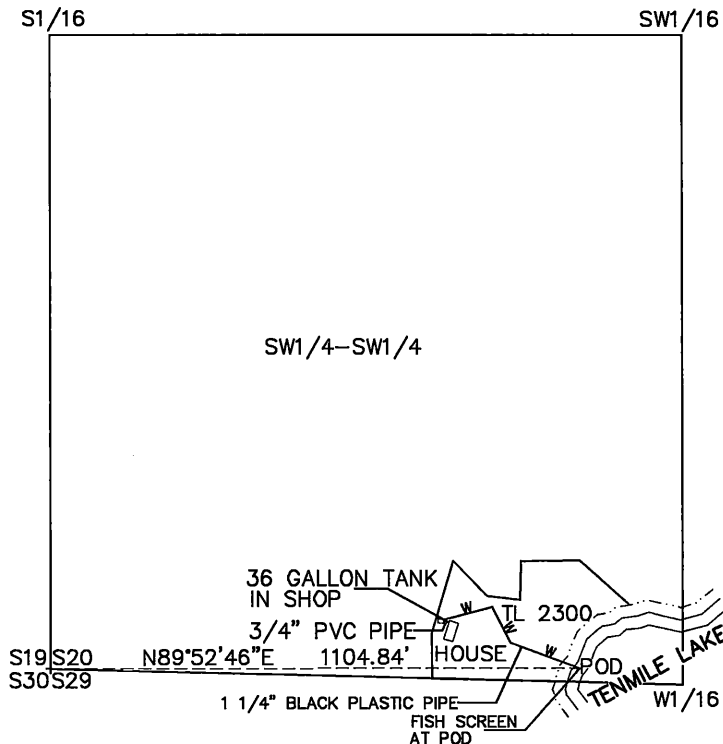

SCALE 1" = 400'


WGS84 LAT. & LONG. FOR POD
N 43°33'12.6"
W 124°09'37.9"

LEGEND:

POD POINT OF DIVERSION

TL TAX LOT

—w— WATER PIPE LINE

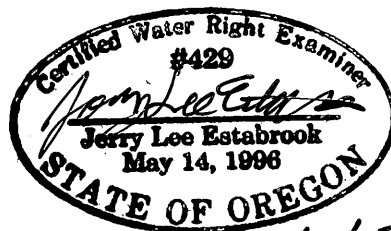

EXPIRES 12/31/15

RECEIVED BY OWRD

EXAMINERS DISCLAIMER STATEMENT:
THE PREPARATION OF THIS MAP WAS FOR THE PURPOSE OF
IDENTIFYING THE LOCATION OF WATER RIGHT ONLY AND HAS
NO INTENT TO PROVIDE DIMENSIONS OR LOCATION OF
PROPERTY OWNERSHIP LINES.

APR 29 2014

SALEM, OR