


T.9S.R.2W.W.M.

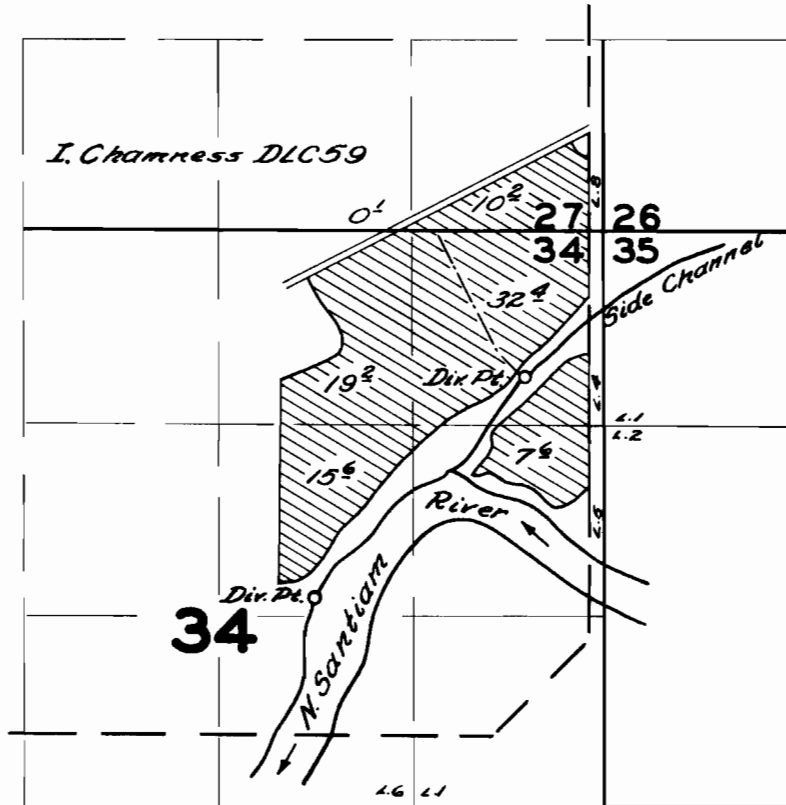

FINAL PROOF SURVEY UNDER

Application No. 28144 Permit No. 22150
IN NAME OF

Y. M. McGill

Surveyed May 19 1958, by C. O. B. [Signature]

Marion Church of God (Seventh Day)

Partial Cancellation
Cert. 26440


RECEIVED

APR 05 2016

WATER RESOURCES DEPT
SALEM, OREGON

WOODPECKER

STAYTON

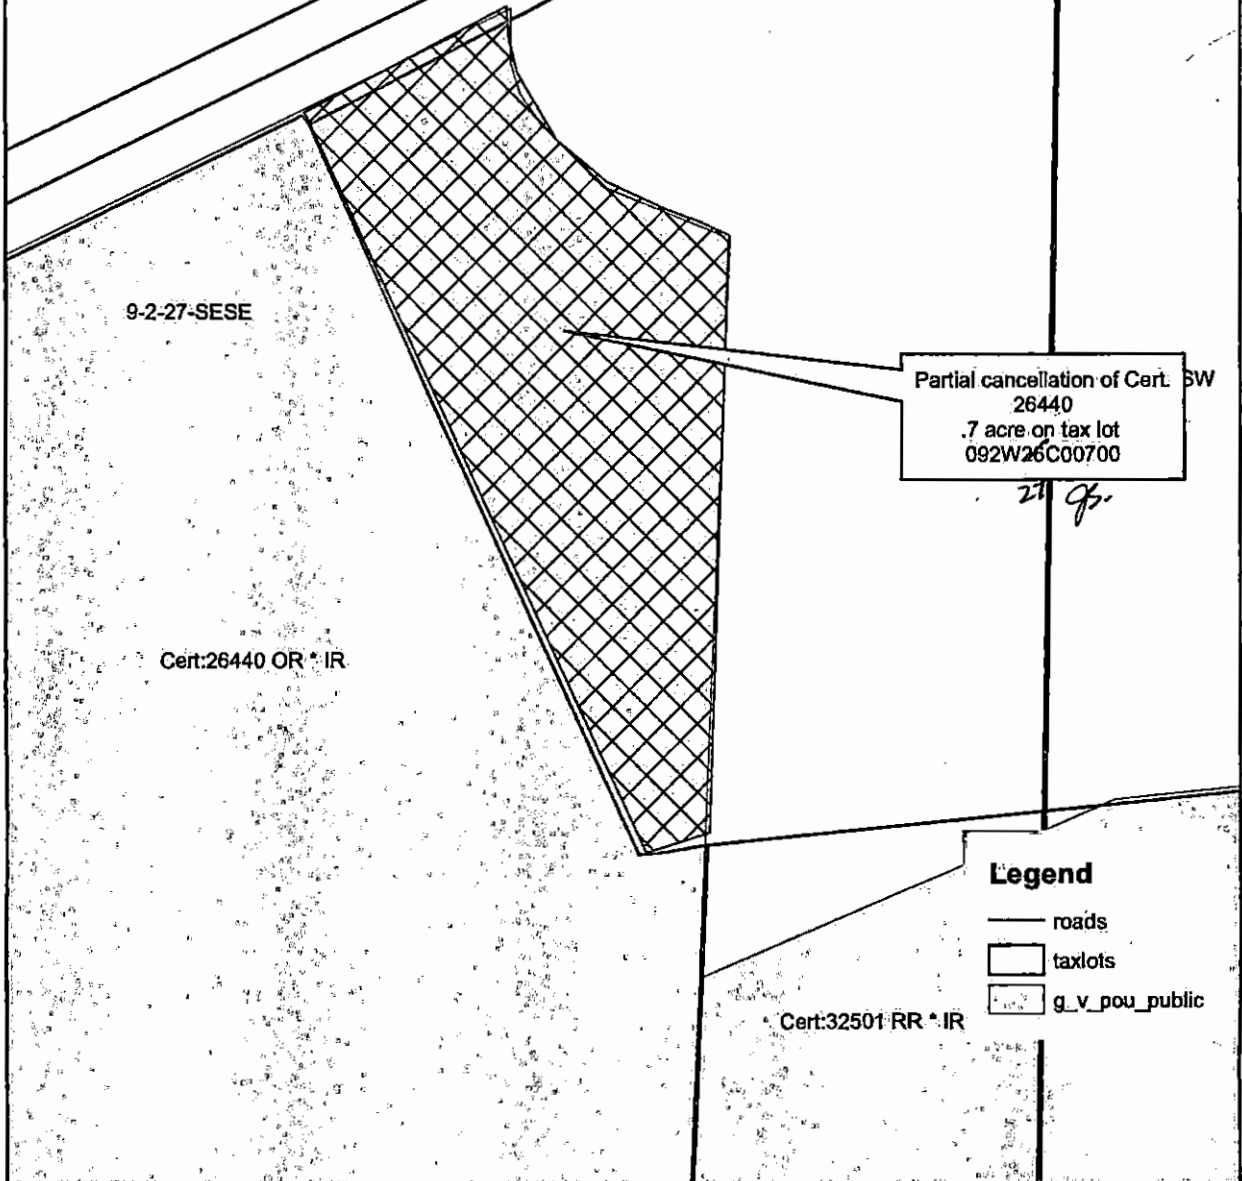

100 50 0 100 Feet

Map prepared by Brent Stevenson

T 12328

