


CLAIM OF BENEFICIAL USE MAP

T28S, R6W, SECTIONS 15, 16, 17, 18, 19, 20, 21, 22, 27, 28, 29, 32, 33, 35
 T29S, R6W, SECTIONS 2, 3, 4, 8, 9, 10, 17
 APPLICATION No. 45720
 PERMIT No. 34106

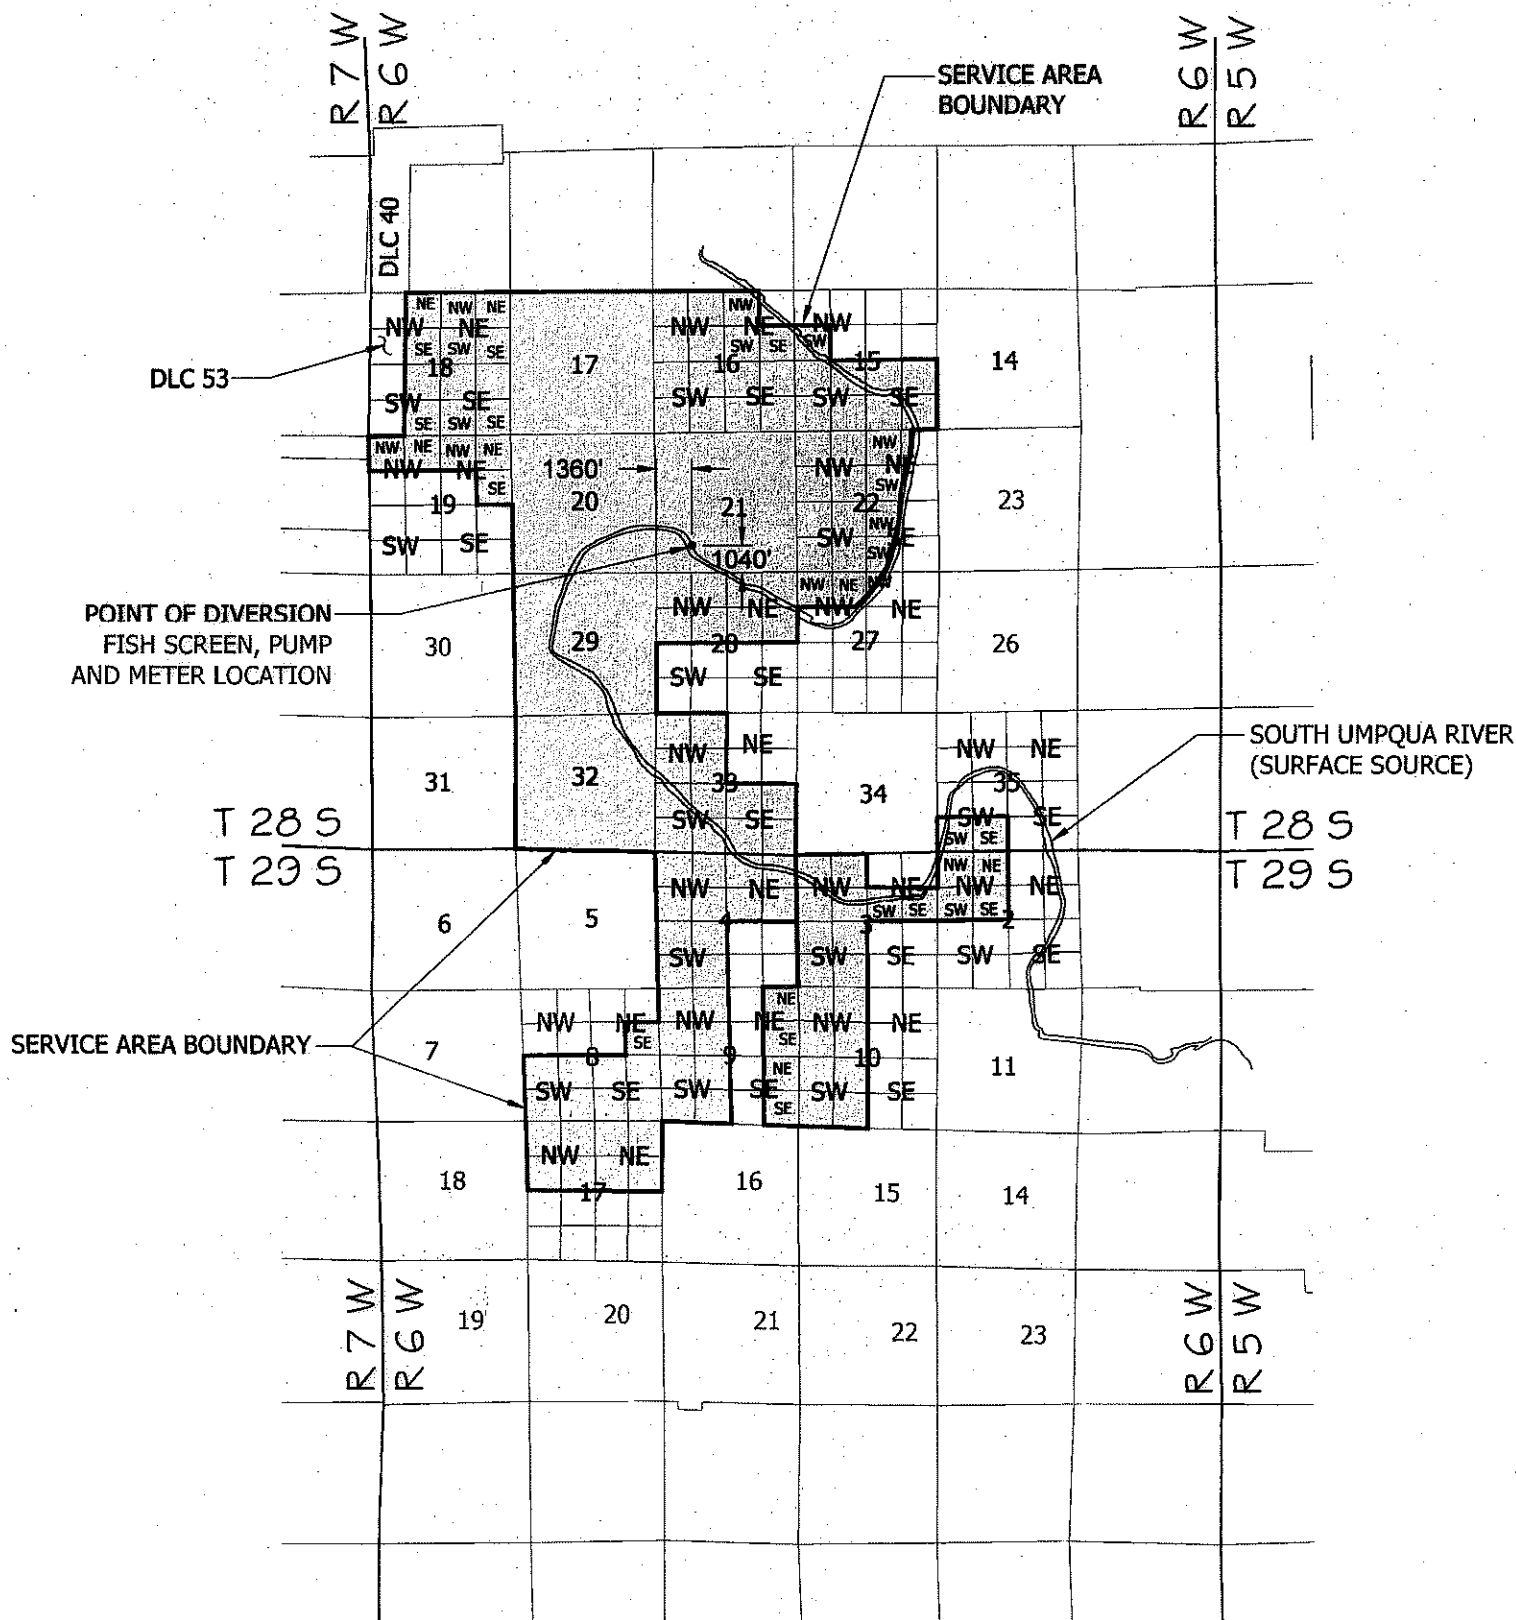


OWNER:

WINSTON-DILLARD WATER DISTRICT
 121 DOUGLAS STREET
 WINSTON, OREGON

1" = 1 MILE = 5280'

NOTE:

THIS MAP IS NOT INTENDED TO PROVIDE LEGAL DIMENSIONS OR LOCATIONS OF PROPERTY OWNERSHIP LINES.

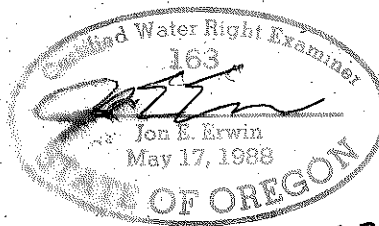

EXP 12-31-17

RECEIVED BY OWRD

AUG 29 2017

SALEM OR

REV 8/24/2017 JES