


FINAL PROOF MAP

TRANSFER T-11188
In the Name of: Miller Forests Inc.

T 10 S, R 2 W, W.M.


Scale 4" = 1 mile

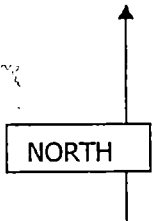

RECEIVED

APR 09 2015

WATER RESOURCES DEPT
SALEM, OREGON

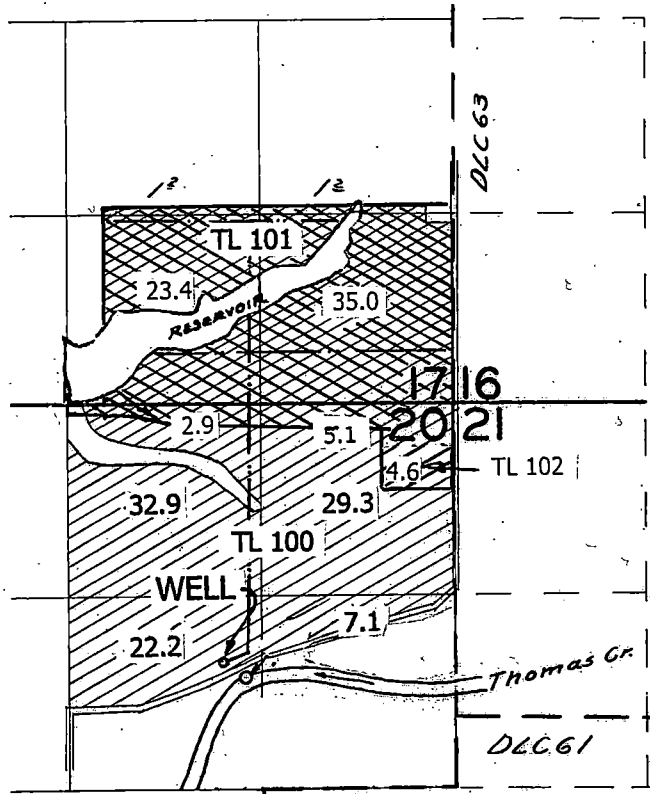


- pipeline - - - -
- Tax Lot line ———
- Section line ———
- 1/4 1/4 line ———
- DLC line - - - -



Lands included in this transfer application.

WELL: 1760' S & 1580' W from the SE corner sec. 17

This map is not intended to provide legal dimensions or locations of property ownership lines.

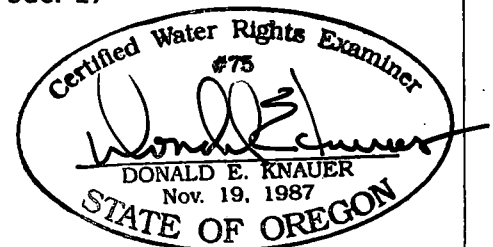

RENEWAL DATE: 6-30-15