

RECEIVED BY OWRD

SE1/4SE1/4 Sec. 11, T.38S., R.5W., W.M.

DEC 19 2014

SALEM, OR

R-13007

Existing Sump Pond No. 6 per P-82747

T.L. 1902 38-5-12

T.L. 2001 38-5-12

T.L. 503 38-5-11

T.L. 502 38-5-11

T.L. 2000 38-5-12

T.L. 1901 38-5-12

T.L. 200

T.L. 101

T.L. 100

Section Corner Fd. Brass Cap

### LEGEND:



Full Pond Surface Area (at elevation 1241.6) = 2.41 acres  
Full Pond Storage Vol. = 20.0 ac-ft

#### Supporting Documents:

Reservoir Application No. R-84228  
Reservoir Permit No. R-13007


Survey tie to center of dam at original Camp Meeting Creek crossing from the SE Corner of Section 11: 464'N and 592'W

A nine page report accompanies this plat.

SCALE:  
1" = 400'

This plat was prepared for the purpose of identifying the location of the water right only. There is no intent to provide dimensions or locations of property ownership lines.

PROJECT NO. 626-99-414
DRAWING NO. 186-8.5.11
DATE: Sept. 10, 2014
SCALE: 1" = 400'
SHEET NO. 1 of 1

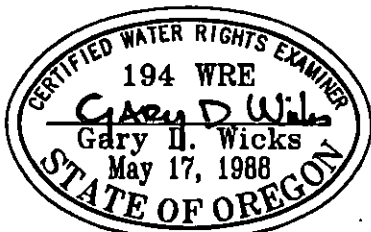

RENEWAL DATE: 6-30-16

### PLAT FOR CLAIM OF BENEFICIAL USE

LOCATED IN:  
SE1/4SE1/4 of Section 11  
Township 38 South, Range 5 West, W.M.  
Josephine County, Oregon

PREPARED FOR:  
PACIFICA  
A Garden In The Siskiyou  
14615 Water Gap Road  
Williams, Oregon 97544

Tel: 541-846-1100

PREPARED BY:  
WICKS ENGINEERING & SURVEYING  
311 N.E. "D" Street  
Grants Pass, OR 97526

Tel: 541-479-3436  
Fax: 541-479-1014